
FORM 51 Stafford

KANSAS

Section 26 Township 22 Range 12W

Well No. #1 W. Sandifer

Company Stanolind Oil and Gas Company

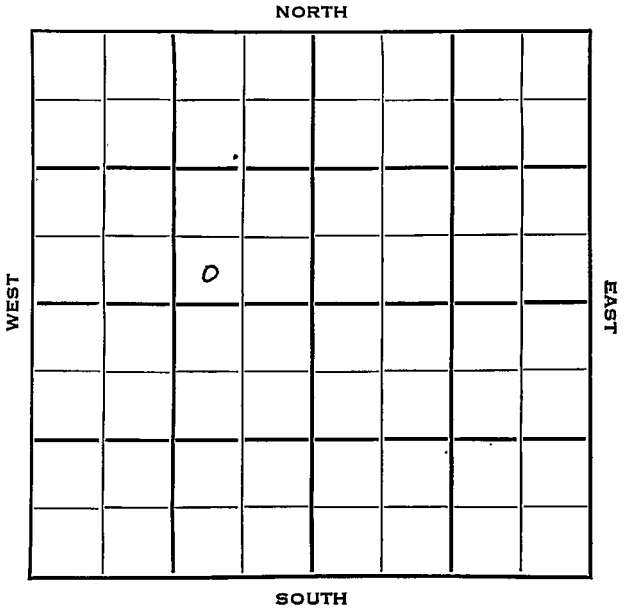

FORM 252-B

Stafford KANSAS ✓

Sec. 26 Twp. 22 R. 12 W

Well No. # 1 W. Sandifer Farm

Stanolind Company

Contractor


Ft. from N. Line

330 Ft. from S. Line

990 Ft. from E. Line

Ft. from W. Line

SW SE NW

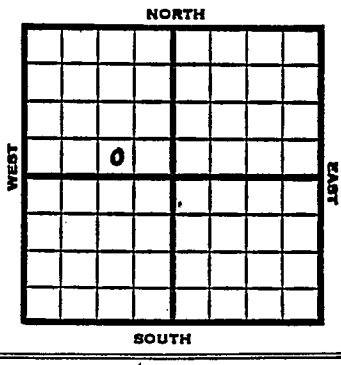

~~1953~~ Elev. 1855' REPORT

3/25 Location

4/2 8" @ 364
7" @ 2680

4/9 Drlg.
Lans 3292
DST 3422-34, 1 hr., 20' M, 585#
DST 3459-85, 1 hr. 25' M
DST 3493-3503, 1 hr., 90' OCM, 700#
Simp 3650, Arb 3704
DST 3663-3705, 1 hr., 1305' sulp wtr 1070#
DST 3662-94, 1 hr., 26' M 990#
Drlg. 3740'

4/16 RTD 3740
6" @ 3720'
CO Testing.

OVER

#1 W. Sandifer

1953
4/22 Spud 3-25-53
D&A
TD 3740
8" @ 364
7" @ 2680
Lans 3292,
DST 3422-34, opn 1 hr., rec. 20' mud 585#
DST 3459-85, opn 1 hr., rec. 25' mud
DST 3493-3503, opn 1 hr., rec. 90' ocm, 700#, Simp 3650, Arb 3704
DST 3663-3705, opn 1 hr., rec. 1305 su wtr., 1070#
DST 3662-94, opn 1 hr., rec. 26' mud 990#
TD 3740
6" @ 3720
CO to 3645
20/3493-98, 16 gwph 500A 1½ bfph 95% wtr., 2000A
1 2/3 bfph 70% wtr. 2000A, 2½ bfph 95% wtr. 48/342336, A-frac
1¼ boph 3 3/4 bwph S/3½ bwph
PB 3410 20/3390-95 1000A
2½ bwph
CO to 3670
20/3655-60, S/5 bwph sd-frac 5 bwph
D&A

ABANDONED

FORM 275 FOR SALE BY KANSAS BLUE PRINT CO.


County Stafford State Kansas

Sec. 26 (Blk. Twp.) 22 (Sur. Rge.) 12W Map No.

Operator Stanolind

Well No. 1 Farm W. Sandifer

Elev. Location SW SE NW

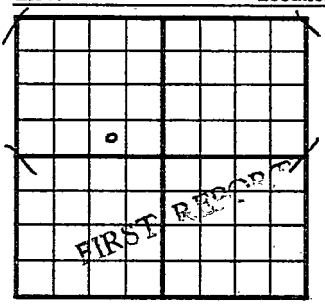

330 Ft. From S Line NW

990 Ft. From E Line Quarter

1st. Report MAR 25 1953

Completion

Remarks

Spudding Date

Drlg. Data

Location

J. G. McGEHEE

MAR 2 7 1953

Scout Cards
Land Small Map
Land Wall Map
Tracings
France Map
Pierce Map
Misc.

Drlg. Data

FORM 275 FOR SALE BY KANSAS BLUE PRINT CO.


County Stafford State Kansas

Sec. 26 (Blk. Twp.) 22 (Sur. Rge.) 12W Map No.

Operator Stanolind

Well No. 1 Farm W. Sandifer

Elev. 1855 Location SW SE NW

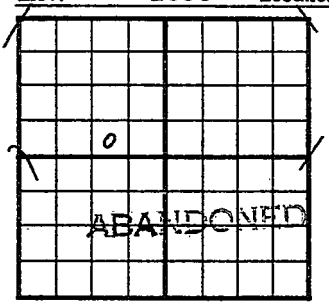

330 Ft. From S Line NW

990 Ft. From E Line Quarter

1st. Report

Completion APR 2 2 1953

Remarks

Spudding Date 3-25-53

Drlg. Data D & A TD 3740

8" @ 364 7" @ 2680 Lans. 3292

DST 3422-34 open 1 hr. Rec. 20' mud

585# DST 3459-85 open 1 hr. Rec. 25'

mud DST 3493-3503 open 1 hr. Rec. 90'

ocm 700# Simp. 3650 Arb. 3704

DST 3663-3705 open 1 hr. Rec. 1305'

sul. wtr. 1070# DST 3662-94 open 1 hr

Rec. 26' mud 990# TD 3740 6" @ 3720

CO to 3645 20/ 3493-98 16 gwph 500 A

1½ bfph 95% wtr. 2000 A 1 2/3 bfph

70% wtr. 2000 A 2½ bfph 95% wtr.

48/ 3423-36 A-frac 1¼ boph 3 3/4 bwph

S/ 3½ bwph PB 3410 20/ 3390-95


1000 A 2½ bwph CO to 3670.

J. G. McGEHEE

Drlg. Data

20/ 3655-60 S/ 5 bwph sd-frac

5 bwph

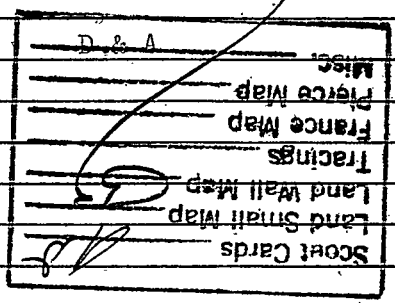

APR 28 1983