

Section 26 Township 22 Range 12 WWell No. # 1 SpangenbergCompany Shelly & Miller

NORTH

WEST

EAST

SOUTH

Sec. 26 Twp. 22 R. 12 W

Well No. # 1 Spangenberg Farm

Shelly & Mibler Company

Contractor


990 Ft. from N. Line

Ft. from S. Line

330 Ft. from E. Line

Ft. from W. Line

SE NE SW

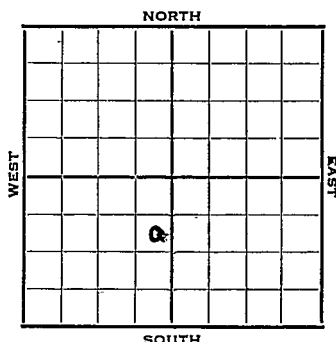

1952 Elev. 1837' REPORT

7/9 Spud 7-7-52
8" @ 244 WOC

7/17 Heeb 3108' Br lime 3239' Lans 3265'
TD 3365' DST

7/23 DST 3335-65, 3/4 hrs. 2850' fluid
288' oil 288' O&GCM 288' ocm
2016' SW 1245#
DST 3399-3404 3/4 hrs. 30' G&OCM
1300#
DST 3431-51, 3/4 hr. 180' HO&GCM
1250# Cong. 3546 V 3550
Simp 3559 Arb. 3641-44 RTD
5" @ 3642'

7/30 CO 3644 S/ 4 Boph & SSW 500 A
S/ 14 Bfph 75% wtr. PB 3540
24/3462-70 1000 A F 110 BO
2 hrs. 20 mins.

8/6 NR

8/13 "

8/20 "

8/27 Spud 7-7-52
Oil Well TD 3644' 8" @ 244
Heeb. 3108 Br Li 3239
Lans. 3265
TD 3365 DST 3335-65 open 3/4 hr.
rec. 2850' fluid 288' oil
288' o & gcm 288' ocm 2016' sw
1245#


OVER

1952

8/27 DST 3399-3404 open 3/4 hr. rec. 30'
GC&OCM 1300#
DST 3431-51 open 3/4 hr. rec. 180'
HO&GCM 1250# Cong. 3546
Viola 3550 Simp. 3559
Arb. 3641
TD 3644 5" @ 3642' CO to 3644
S/ 4 boph & SSW 500 A S/ 14 bfph
75% wtr. PB 3540 24/ 3462-70
1000 A F/ 110 bo 2 hr. 20 min.
Comp. 253 bopd

COMPLETED

County Stafford State Kansas
 Sec. 26 (Blk. 22 (Sur. 12W Map No.
 (Twp.) (Rge.)
 Operator Shelly & Miller
 Well No. 1 Farm Spangenberg
 Elev. Location SE NE SW

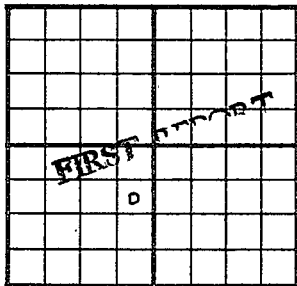


990 Ft. From N Line SW
330 Ft. From E Line Quarter
 1st. Report JUL 9 1952
 Completion
 Remarks
 Spudding Date 7-7-52

Drlg. Data

8" @ 244 WOC

J. G. McGEHEE

County Stafford State Kansas
 Sec. 26 (Blk.) 22 (Sur. Rge.) 12W Map No. _____
 Operator Shelly & Miller
 Well No. 1 Farm Spangenberg
 Elev. 1837 Location SE NE SW

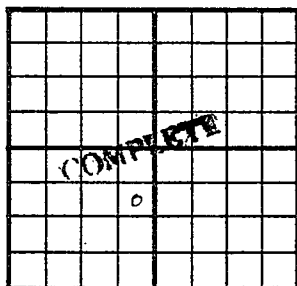

990 Ft. From N Line SW
330 Ft. From E Line Quarter

1st. Report

Completion AUG 27 1952

Remarks Pleasant Grove Pool

Spudding Date 7-7-52

Drlg. Data Oil well TD 3644

8" @ 244 Heeb. 3108 Br. lime 3239

Lans. 3265 TD 3365 DST 3335-65

open 3/4 hr. Rec. 2850' fluid 288' oil

288' o & gcm 288' ocm 2016' sw 1245#

DST 3399-3404 open 3/4 hr. Rec. 30' gc

& ocm 1300# DST 3431-51. open 3/4 hr

Rec. 180' ho & gcm 1250# Cong. 3546

Viola 3550 Simp. 3559 Arb. 3641

TD 3644 5" @ 3642 GO to 3644

S/ 4 boph & SSW 500 A S/ 14 bph

75% water PB 3540 24/ 3462-70

1000 A E/ 110 bo 2 hr. 20 min.

Comp. 253 bopd