

Stafford

KANSAS
12W

Sec. 26 Twp. 22 R. 12W

Well No. #3 Spangenberg
#1 Spangenberg "B" Farm

Shelly-Miller Company

Shelly-Miller Contractor


_____ Ft. from N. Line

990 Ft. from S. Line

_____ Ft. from E. Line

330 Ft. from W. Line

NW SW SE

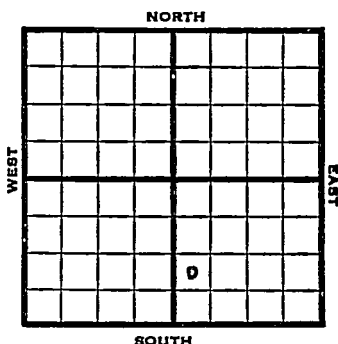

1953 Elev. 1840' REPORT

1/28 Spud 1-23-53
8" @ 238
Drlg. 1289

2/5 Heeb 3111, Br li 3242, Lans 3269
DST 3397-3431, 1 hr., 4 1/4 M
gas, 240' gcm, 1480#
DST 3435-52, 1 hr., 60' hly ocm,
400#
Drlg. 3475'

2/12 Simp 3666
RTD 3670
5" @ 3538 elect log CO

2/19 48/3461-70, FU 1500' oil hr.?
POP
P/173 BO 21 hrs.

2/26 N.R.

3/11 Spud 1-23-53 Oil well TD 3670
8" @ 238 Heeb 3111' Br li 3242'
Lans 3269'
DST 3397-3431 open 1 hr. rec 4 1/4 MCFG
240' GCM 1480#
DST 3435-52 open 1 hr. rec 60' HOCM
400# Simp. 3666' TD 3670
5" @ 3538 CO to 3507 48/3461-70
FU 1500' oil 1 hr. P/173 BO 21 hr.
Comp. BHB 706 BOPD

COMPLETED

Map No. _____ Sec. 26 Twp. 22 R. 12W

Well No. 3 Spangenberg

Shelly - Miller Company

CORRECTION Contractor

NW SW SE

SECTION PLAT

_____ Ft. from N. Line

990 Ft. from S. Line

_____ Ft. from E. Line

330 Ft. from W. Line

		o	

Stafford County

Location _____

Rig up _____

Drilling and Remarks:

Reported

#1 Spangenberg "B"

RECORD

Cased _____ in., _____ ft.

Sand _____

Gas _____

Oil _____

Total Depth _____

PRODUCTION

1st 24 hrs. Nat. _____

1st 24 hrs. after shot _____

Gas _____ Cu. Ft.

Dry Hole _____

Abandoned _____

Date

FFR 18 1953

19

J. G. McGEHEE

Scout

