
FORM 51 Stafford KANSAS

Section 26 Township 22 Range 12W

Well No. 4 Spangenberg

Company Shelly-Miller

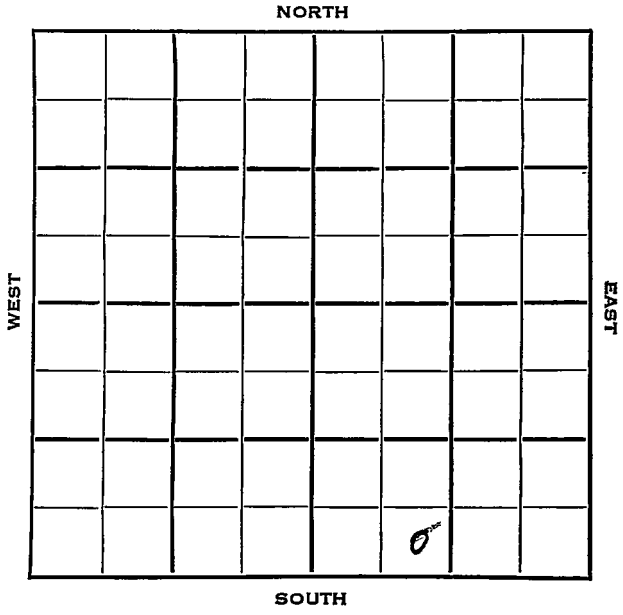

Stafford KANSAS

SEC.	TWP.	R.
26	22	12W

WELL NO.

#4 Spangenberg FARM

COMPANY

Shelly-Miller

CONTRACTOR

Pleasant Grove Pool


____ Ft. from N. Line

330 Ft. from S. Line

____ Ft. from E. Line

990 Ft. from W. Line

SE SW SE

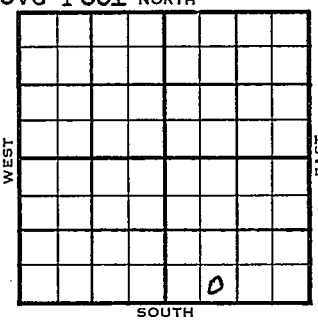

1954	ELEVATION 1837' REPORT
3/10	M I R
3/17	8" @ 225' Heeb 3104', Br li 3237', Lans 3263', DST 3322-40', 1/2 hrs., 9' m 0# Drlg. 3360'
3/24	DST 3428-48', 1 hr., 30' O&GCM, 1250# DST 3455-75', 1 hr.,100' HO&GCM, 415# V 3539', Simp 3634' DST 3606-41', 1 hr., 25' M, 0# RTD 3654 Schl 5" @ 3514'
3/31	CO 3470' 23/ 3454-62 3000 A F/ 56 BO 10 hrs. S/ 16 boph POP
4/7	NR
4/21	Spud 3-11-54 Oil well TD 3654 8" @ 225 Heeb 3104 Br. lime 3237 Lans. 3263 DST 3322-40 open ½ hr rec 9' mud 0# DST 3428-48 open 1 hr rec 30' O & GCM 1250# DST 3455-75 open 1 hr rec 100' HO & GCM ~~XXX~~# 415# Viola 3539 Simp 3634 DST 3606-41 open 1 hr rec 25' mud 0# TD 3654 5" @ 3514 CO to 3470 23/3454-62 3000 A S/down F/56 BO 10 hr. S/16 BOPH Comp. 276 BOPD COMPLETED

DX-78

FORM 275 FOR SALE BY KANSAS BLUE PRINT CO.


County Stafford State Kansas

Sec. 26 (Blk. Twp.) 22 (Sur. Rge.) 12W Map No.

Operator Shelly-Miller

Well No. 4 Farm Spangenberg

Elev. Location SE S W SE

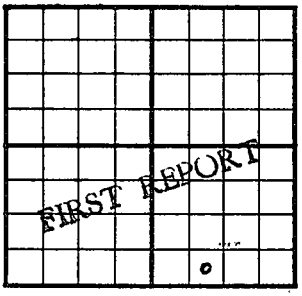

330 Ft. From S Line SE

990 Ft. From W Line Quarter

1st. Report MAR 1 0 1954

Completion

Remarks

Spudding Date

Drlg. Data Pleasant Grove Pool

M IR

J. G. McGEHEE

FORM 275 FOR SALE BY KANSAS BLUE PRINT CO.


County Stafford State Kansas

Sec. 26 (Blk. Twp.) 22 (Sur. Rge.) 12W Map No.

Operator Shelly-Miller

Well No. 4 Farm Spangenberg

Elev. 1837 Location SE SW SE

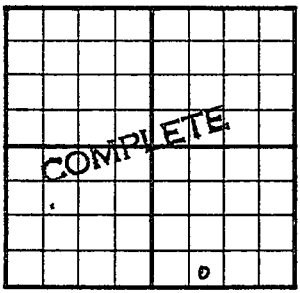

330 Ft. From S Line SE

990 Ft. From W Line Quarter

1st. Report

Completion APR 21 1954

Remarks Pleasant Grove Poo

Spudding Date 3-11-54

Drlg. Data Oil well TD 3654

8" @ 225 Heeb. 3104 Br. lime 3237

Lans. 3263 DST 3322-40 open ½ hr.

Rec. 9' mud 0# DST 3428-48 open 1 hr.

Rec. 30' o & gcm 1250# DST 3455-75

open 1 hr. Rec. 100' ho & gcm 415#

Viola 3539 Simp. 3634 DST 3606-41

open 1 hr. Rec. 25' mud 0# TD 3654

5" @ 3514 CO to 3470 23/ 3454-62

3000 A S/ down F/ 56 bo 10 hr.

S/ 16 boph Comp. 276 bopd

J. G. McGEHEE