

Stafford

KANSAS

Sec. 26 Twp. 22 R. 13W ✓

Well No. #1 Ahnert Farm

NCRA et al Company


Ahnert (NCRA, Cont.)

Pool Ft. from N. Line

330' Ft. from S. Line

Ft. from E. Line

990' Ft. from W. Line

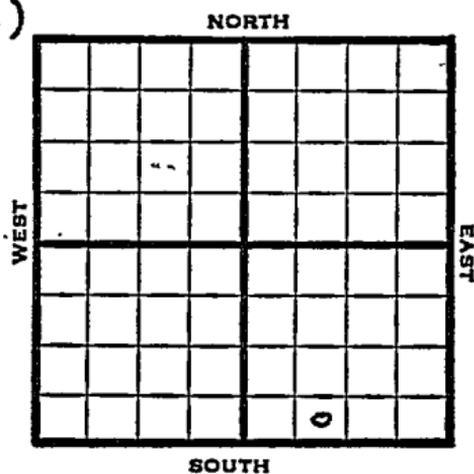

SE SW SE

1949

Elev 1888' REPORT

- 7/20 8" @ 255'
- 7/27 Drlg 2690'
- 8/3 Lansing 3399'
- Drlg. 3456'
- 8/10 TD 3790'
- Arb. 3770'
- Aband.

ABANDONED

Kansas

Map No. _____ Sec. 26 Twp. 22 R. 13W

Well No. 1 Ahnert

NCRA et al. _____ Company

NCRA _____ Contractor

SE SW SE

FIRST REPORT
SECTION PLAT

_____ Ft. from N. Line

330

_____ Ft. from S. Line

_____ Ft. from E. Line

990

_____ Ft. from W. Line

Stafford County

RECORD

Location _____

Cased _____ in., _____ ft.

Rig up _____

Sand _____

Drilling and Remarks:

Gas _____

Oil _____

Total Depth _____

8" @ 255

PRODUCTION

1st 24 hrs. Nat. _____

1st 24 hrs. after shot _____

Gas _____ Cu. Ft.

Dry Hole _____

Abandoned _____

Date

JUL 20 1949

19

S. J. LEWIS

Scout

