


Section 26 Township 22 Range 13-W

Well No. #2 Ahnert

Company Stanolind

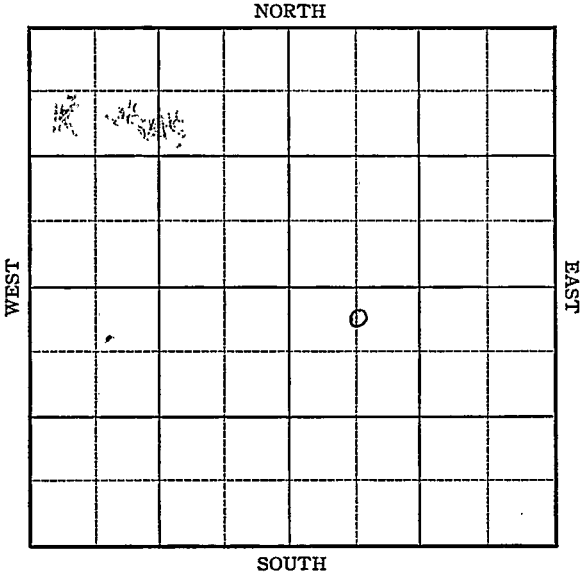

Sec. 26 Twp. 22 R. 13-W

Well No. #2 Ahnert Farm

Stanolind Company


Ahnert

330 Ft. from N. Line

_____ Ft. from S. Line

_____ Ft. from E. Line

660 Ft. from W. Line

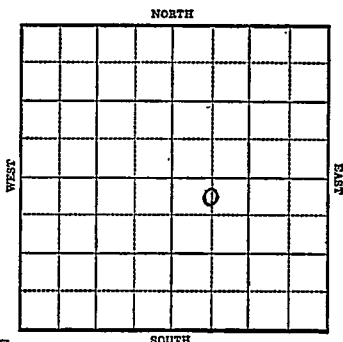

C NL NW SE *El. 1886*

1943

R E P O R T

- 2/17 Derrick
- 2/24 13" Casing set 244
Anhy 625
Drlg. 1000'
- 3/3 Drlg. 1820'
- 3/10 Drlg. 3140'
- 3/17 Lans 3400 SO
3707 Drill pipesstuck.
- 3/24 Simp 3711
Drlg. 3792 SSO
- 3/31 Arb 3760
Water
T.D. 3850'

KANSAS

Map No. 82 Sec. 26 Twp. 22 R. 13WWell No. 2 Ahnert

Stanolind

Company

FIRST REPORT

Contractor

C NL NW SE

SECTION PLAT

330

Ft. from N. Line

Ft. from S. Line

Ft. from E. Line

660

Ft. from W. Line

AHNERT POOL

Location _____

Rig up _____

Drilling and Remarks:

Derrick

RECORD

Cased _____ in., _____ ft.

Sand _____

Gas _____

Oil _____

Total Depth _____

PRODUCTION

1st 24 hrs. Nat. _____

1st 24 hrs. after shot _____

Gas _____ Cu. Ft.

Dry Hole _____

Abandoned _____

Date

FEB 17 1943

19

S. J. LEWIS

Scout

Stafford

Map No. ~~26~~ ^{KANSAS} Sec. 26 Twp. 22 R. 13W

Well No. 2 Ahnert

Stanolind

Company

ABANDONED

Contractor

C NL NW SE

SECTION FLAT

330 Ft. from N. Line

Ft. from S. Line

Ft. from E. Line

660 Ft. from W. Line

		o	

AHNERT POOL

Location

Rig up

Drilling and Remarks:

*Per 73760**Water.*

RECORD

Cased _____ in., _____ ft.

Sand _____

Gas _____

Oil _____

Total Depth *3850*

PRODUCTION

1st 24 hrs. Nat. _____

1st 24 hrs. after shot _____

Gas _____ Cu. Ft.

Dry Hole _____

Abandoned _____

Date

MAR 3 1 1943

19

S. J. LEWIS

Scout