

Section 26 Township 22 Range 11WWell No. #1 DohrmanCompany Trans-Era Pet.

NORTH

			0				

WEST

EAST

SOUTH

Stafford

KANSAS

Sec. 26 Twp. 22 R. 14W

Well No. #1 Dohrman Farm

Trans-Era Pet. Company

Trans-Era Contractor

Wildcat.


Ft. from N. Line

330 Ft. from S. Line

330 Ft. from E. Line

Ft. from W. Line

SE SE NW

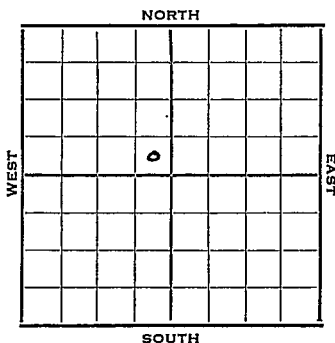

1953

Elev. 1932'

REPORT

7/8

Spud 7-3-53
8" @ 264'
Anhy 827'
Drlg 2741'


7/15

Spud 7-3-53
D&A
TD 3885
8" @ 264'
Anhy 827, Heeb 3319, Br line 3451,
Lans 3463
DST 3588-95, opn 1 hr., rec. 12' mud,
O#
B KC 3700, Marm 3712, G ong 3743,
Viola 3762, Arb 3849
TD 3885
D&A

ABANDONED

J. G. McGEHEE

County Stafford State Kansas
 Sec. 26 (Blk. 22) (Sur. 14W) Map No. 14W
 Operator Trans-Era Pet.
 Well No. 1 Farm Dohrman
 Elev. 1932 Location SE SE NW

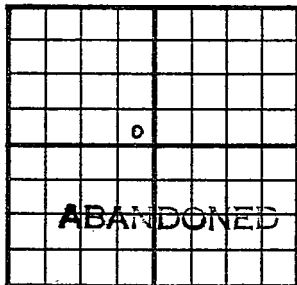

330 Ft. From S Line NW
330 Ft. From E Line Quarter
 Ist. Report
 Completion JUL 15 1953
 Remarks Wildcat
Trans-Era - Contr.
 Spudding Date 7-3-53

Drlg. Data D & A TD 3885
8" @ 264 Anhy 827 Heeb. 3319
Br. lime 3451 Lens. 3463 DST 3588-95
open 1 hr. Rec. 12' mud 0# B KC 3700
Marm. 3712 Cong. 3743 Viola 3762
Arb. 3849 TD 3885

D & A

J. G. McGEHEE