


Section 26 Township 22S Range 14W

Well No. #1 Dohrman

Company Sierra

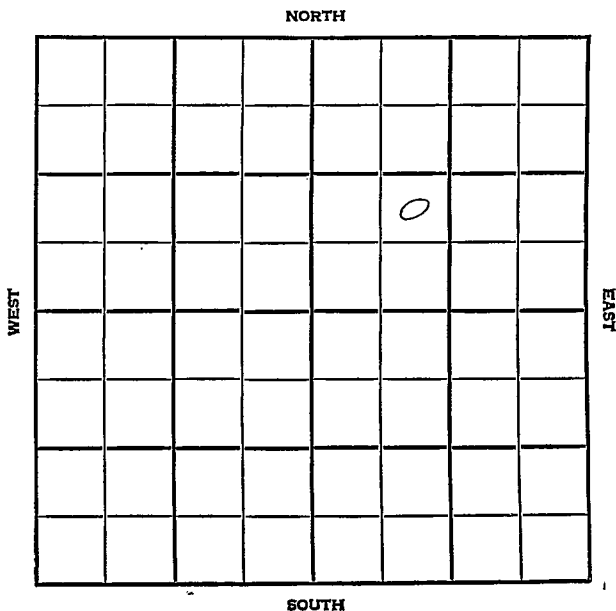

Stafford

KANSAS

SEC.	TWP.	R.
26	22	14W

WELL NO.

#1 Dohrman

FARM

COMPANY

Sierra

CONTRACTOR

Co.

Oscar So.


_____ FT. FROM N. LINE

_____ FT. FROM S. LINE

_____ FT. FROM E. LINE

_____ FT. FROM W. LINE

NE SW NE

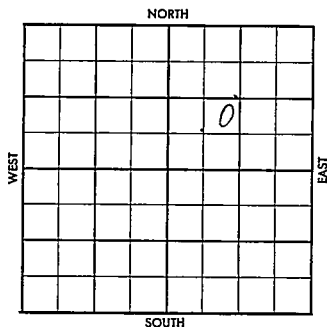

1956	ELEVATION	REPORT
------	-----------	--------

8-29

Comm. 8-27-56
8" @ 222 w/175

County Stafford Elev. _____
 Sec. 26 Twp. 22S Rge. 14W
 Company Sierra
 Farm Name Dohrman No. 1

TOPS	DEPTH	LOG	DATUM	Loc. in Sec.
Anh.				NE SW NE
Tr.				
H.				
Tr.				
Dg.				
Bl.				Jim Morris
L.				Geol.
K.C.				Contr.
B.K.C.				Co. #9
Ce.				
C.				Pool
M.				Oscar So.
M.				
K.				
Mz.				
Ma.				
V.				
S.				
S.				
A.				
R.				
Pe.				
G.				
T.D.				

FIRST REPORT	
	0
AUG 29 '56	

Date Comm. 8-27-56Bl 222 w/175;

2001 7, 236

G. S.

County StaffordElev. 1934Sec. 26 Twp. 285Rgs. UWCompany SierraFarm Name DohrmanNo. 1

TOPS	DEPTH	LOG	DATUM
Anh.			
Top.			
H.	3318	3320	
Tr.		3341	
Dg.		3356	
Bl.	3448	3451	
L.	3461	3464	
K.C.			
B.K.C.			
Ge.			
C. <u>Detrit 2n</u>		3734	
M.			
M.			
K.			
Mz.			
Mo.			
V.		3757	
S.		3797	
S.			
A.			
R.			
Pe.			
G.			
TD.	3840		

Loc. in Sec.

NE SW NE

Jim Morris
Geol.

Contr.

Co. #9

Pool

Oscar So.

NOV 7 '56	
	0
COMPLETE	

Date Comm. 8-27-568" 222 w/175; SEP 5 '56 DST 3581-93or 1 in 45' OCM + 60' Mdy oilBHP 810/120" @ 3612 SEP 12 '56DST 3641-59 30" net 15'Md All. press 0/120 4 1/2 @3720/125 SEP 19 '56 Co 3684 1/231/3652-60 N.S. 1/2 # 1 1/4 BW+ 550 PB 3642 40/3624-34 N.S.1/2 # 3 BFPH 5 in (Tr. oil)

SEP 28 '55 PB 3619 9/3610-13

PB 8 GW no oil 1/2 \$4.68

BW in 1 hr PB 3599 16/

3585-89 tst 2 60 f wph

1/2 \$39 3/4 BF in 3 hrs

50% wtr POT OCT 3 '56 OCT 10 '56

P. 1 Bo in 20" + 80% wtr

OCT 17 '56 OCT 24 '56 P. 14.63 Bo

80% wtr 24 hrs. OCT 31 '56

NOV 7 '56 Ph P. 10 Bopd +

75% wtr.

26-22-14

new new