

Stafford KANSAS

SEC.	TWP.	R.
26	22	14W ✓

WELL NO. **1 Maud** FARM

COMPANY **Lion Oil**

CONTRACTOR


S. Oscar Pool

_____ Ft. from N. Line

990 _____ Ft. from S. Line

990 _____ Ft. from E. Line

_____ Ft. from W. Line

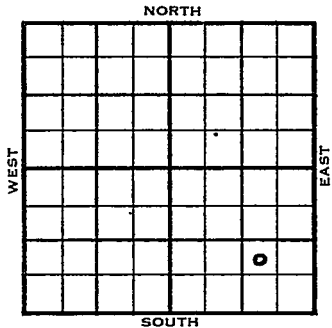

NW SE SE

1954	ELEVATION	REPORT
	1928'	

2/17 Location

2/24 8" @ 339'
Drlg 2215'

3/24 8" Spud 2-20-54 Oil well TD 3817
@ 339 Heeb 3306 Lans 3449
DST 3470-97 open 1 hr rec 60' gas,
150' wtr. 1080#
DST 3545-81 open 1 hr rec 240' gas,
30' SO & GCM, 90#
DST 3587-3600 open 1 hr rec 20' mud
DST 3589-3600 open 1 hr rec 25' SOCM
0#
DST 3598-3646 open 1 hr rec 130' SW
0# Viola 3723 Simp. 3760
DST 3735-63 open 1 hr rec 45' gas,
15' GCM 590# Arb. 3814 TD 3817
5" @ 3815 CO to 3817 B/16 GOPH
500 A S/18 BOPH S/7 BOPH
Comp. 366 BOPD

COMPLETED


County **Stafford** State **Kansas**

Sec. **26** (Blk. Twp.) **22** (Sur. Rge.) **14W** Map No.

Operator **Lion Oil**

Well No. **1** Farm **Maud**

Elev. Location **NW SE SE**

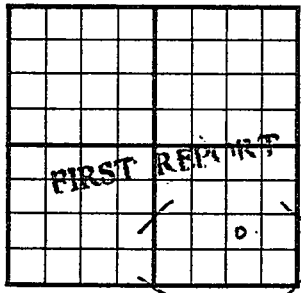

990 Ft. From **S** Line **SE**

990 Ft. From **E** Line Quarter

1st. Report **FEB 17 1954**

Completion

Remarks

Spudding Date

Drlg. Data **S. Oscar Pool**

Location

