

26

22

14 W

Section _____ Township _____ Range _____

1 Smith "J"

Well No. _____

Company _____ Petroleum Inc. _____

NORTH

						0	

WEST

EAST

SOUTH

Stafford KANSAS

SEC.	TWP.	R.
26	22	14W ✓

WELL NO.

I Smith "J"

FARM

COMPANY

Petroleu, Inc.

CONTRACTOR

Petroleu, Inc.


Wildcat

990 _____ Ft. from N. Line

_____ Ft. from S. Line

990 _____ Ft. from E. Line

_____ Ft. from W. Line

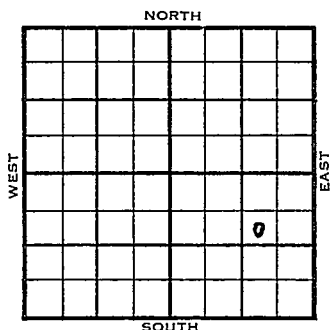

SW NE SE

Stanolind - DHM - Lion Farmout


	ELEVATION	REPORT
1953	1928'	

11/18 8" @ 267'
Anhy 826'
Drlg. 2960'

1954
1/13 Spud 11-12-53 Oil well TD 3865
8" @ 267 Anhy 826 Heeb 3307'
Br. lime 3438' Lans 3450'
DST 3548-80 open 45 min, rec 10' mud
DST 3606-20 open 1 hr rec 6' VHO CM
60' O & GCW, 600' gas. 725#
Cong. 3710' Viola 3724' Simp. 3758
DST 3722-3800 open 1 hr. rec 60' mud
125# Arb. 3815' TD 3865'
DST 3814-21 open 1 hr rec 475' clean
oil 850# 5" @ 3863 CO to 3865'
8/3817-19 16 GOPH 250 A
S/4 BOPH
Comp. 301 BOPD

COMPLETED

County Stafford State Kansas
 Sec. 26 (Blk.) 22 (Sur.) 14W Map No.
 Operator Petroleum Inc.
 Well No. 1 Farm Smith "J"
 Elev. 1928 Location SW NE SE

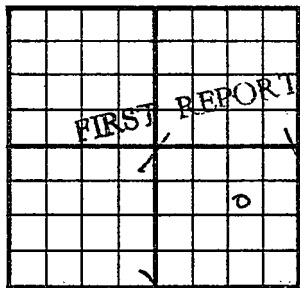


990 Ft. From N Line SE
990 Ft. From E Line Quarter
 1st. Report NOV 18 1953
 Completion _____
 Remarks Stanolind-DEM
Lion Farmout
Petroleum Inc. - Contr.
 Spudding Date _____

Drlg. Data Wildcat

8" @ 267 Anhy 826 drlg. 2960

County Stafford State Kansas
 Sec. 26 (Blk.) 22 (Sur.) 14W Map No.
 Operator Petroleum Inc.
 Well No. 1 Farm Smith "J"
 Elev. 1928 Location SW NE SE

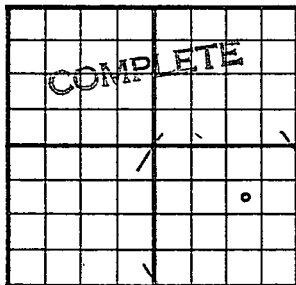

990 Ft. From N Line SE
990 Ft. From E Line Quarter
 Ist. Report
 Completion JAN 13 1954
 Remarks Wildcat
Petroleum Inc. - Contr.
 Spudding Date 11-12-53

Drlg. Data Oil well TD 3865
8" @ 267 Anhy 826 Heeb. 3307
Br. lime 3438 Lans. 3450 DST 3548-80
open 45 min. Rec. 10' mud DST 3606-20
open 1 hr. Rec. 6' whocm 60' o' & gcw
600' gas 725# Cong. 3710 Viola 3724
Simp. 3758 DST 3722-3800 open 1 hr.
Rec. 60' mud 125# Arb. 3815 TD 3865
DST 3814-21 open 1 hr. Rec. 475' clean
oil 850# 5" @ 3863 CO to 3865
8/ 3817-19 16 goph 250 A S/ 4 boph
Comp. 301 bopd

J. G. McGEHEE