


DX 78-1 Stafford

KANSAS

Section 26 Township 22 Range 11W

Well No. 1 Stewart

Company Leben Oil & Aurora Gas

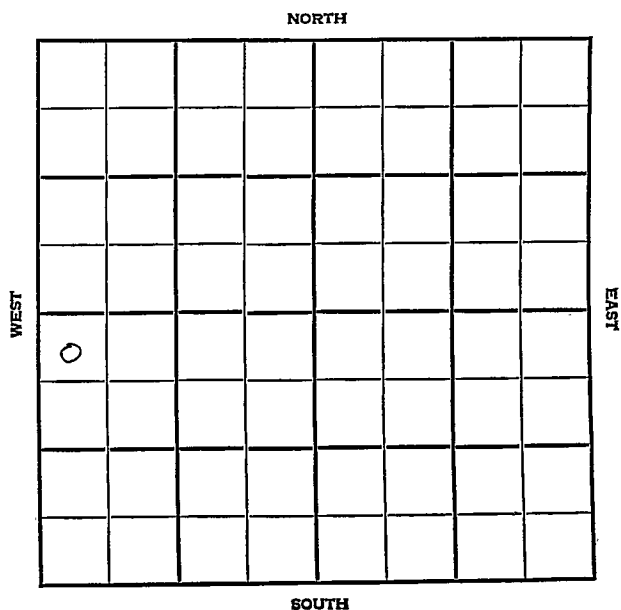

Stafford KANSAS

SEC.	TWP.	R.
26	22	14 W

WELL NO. # 1 Stewart FARM

COMPANY Leben Oil & Aurora Gas

CONTRACTOR Leben Wildcat


330 Ft. from N. Line

Ft. from S. Line

Ft. from E. Line

330 Ft. from W. Line

NW NW SW

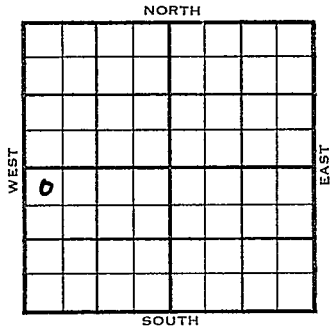

Sinclair FO. NCRA & Trans-Era-DHM

1955 ELEVATION REPORT

4/27 RJR

County	Stafford		State	Kansas
Sec.	26	(Blk. Twp.) 22	(Sur. Rge.) 14W	Map No.

Sec. 26 (Blk. Twp.) 22 (Sur. Rge.) 14W Map No.

Operator **Leben Oil & Aurora Gas**

Well No. **1** Farm **Stewart**

Elev.	Location	NW	NW	SW
-------	----------	----	----	----

330 Ft. From N Line SW

330 Ft. From VI Line Quarter

1st. Report APR 27 1955

Completion	Sinclair farmout
Remarks	NCRA & Trans-Era DEN

Remarks NCRA & Trans-Era DEB

Leben - Contr.

Spudding Date

Drig. Data

Wildcat

BUR

