


Section 26 Township 22 Range 11W

Well No. #2 Smith "J"

Company Petroleum Inc.

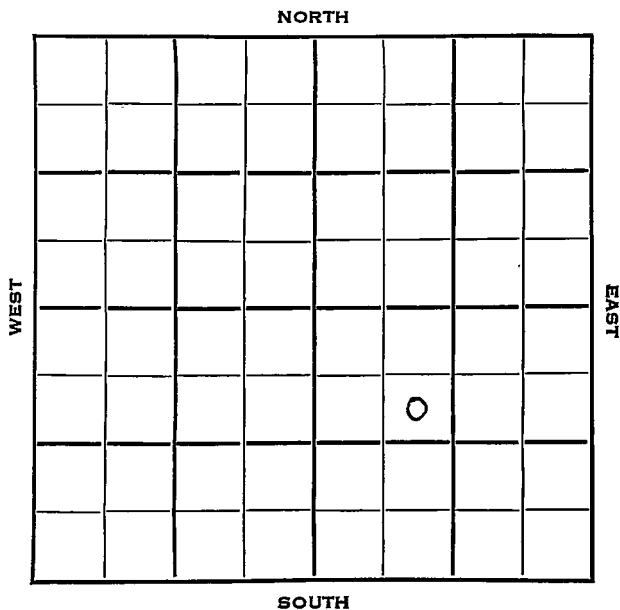

Stafford

KANSAS

SEC. 26	TWP. 22	R. 14W ✓
------------	------------	-------------

WELL NO. #2 Smith "J" FARM

COMPANY Petroleum Inc.

CONTRACTOR Garvey Drlg.


S. Oscar Pool

990 Ft. from N. Line

Ft. from S. Line

Ft. from E. Line

990 Ft. from W. Line

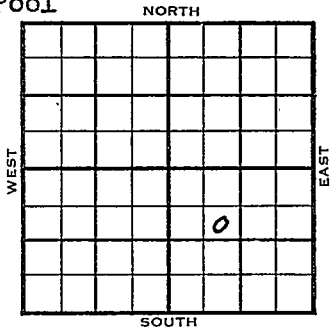

SE NW SE

1954	ELEVATION 1929'	REPORT
------	--------------------	--------

1/13 Spud 1-6-54
8" @ 347'
Anhy 820', Heeb 3311', Br. Lime 3445'
Lans 3456'
Drlg 3535'

1/20 DST 3578-87, 1 hr, 20' VHOCM, 120'
froggy oil 1060# Simp 3785'
Arb. 3835' RTD 3855 5" @ 3700
CO 20/3580-85

1/27 500 A S/ 8 boph 3000 A S/ 10 boph

2/24 Spud 1-6-54 Oil well TD 3855
8" @ 347' Anhy 820' Heeb 3311
Br lime 3445' Lans 3456
DST 3578-87 open 1 hr rec 20' VHOCM
120' froggy oil, 1060# Simp 3785
Arb. 3835' TD 3855 5" @ 3700
20/3580-85 500 A S/8 BOPH 3000 A
S/10 BOPH Comp. 372 BOPD

COMPLETED

