


DX 78-1 Stafford

KANSAS

Section 26 Township 22S Range 11W

Well No. #3 Smith "J"

Company Petroleum Inc.

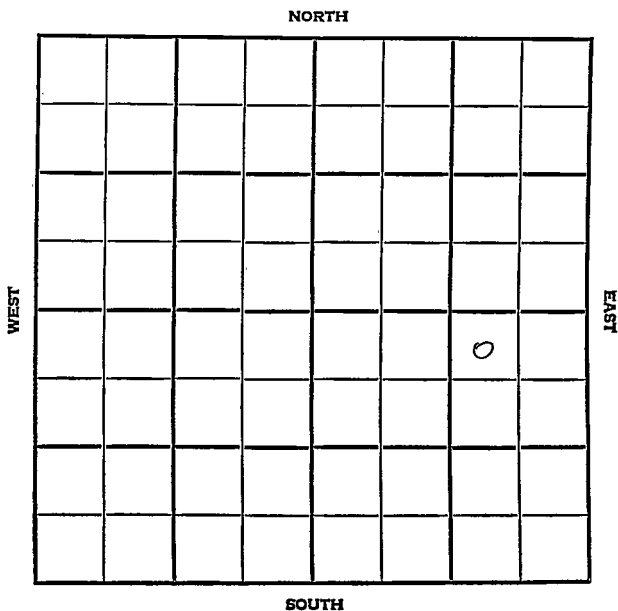

SEC.	26	TWP.	22	R.	14W
------	----	------	----	----	-----

WELL NO.

#3 Smith "J"

FARM

COMPANY

Petroleum Inc.

CONTRACTOR

Garvey

Oscar So.


_____ FT. FROM N. LINE

_____ FT. FROM S. LINE

_____ FT. FROM E. LINE

_____ FT. FROM W. LINE

NW NE SE

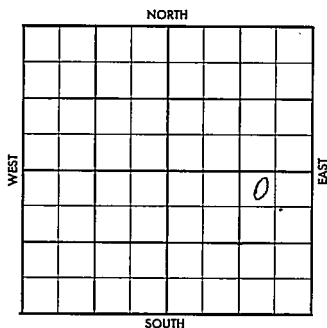

1956	ELEVATION	REPORT
------	-----------	--------

8-29

Comm. 8-26-56

Drlg. 1010'

Anh. 810'

County **Stafford** Elev. **11W**
 Sec. **26** Twp. **22S** Rge. **11W**
 Company **Petroleum, Inc.**
 Farm Name **Smith "J"** No. **3**

TOPS	DEPTH	LOG	DATUM	Loc. in Sec.
Anh.	010			NW NE SE
Tp.				
H.				
Tr.				
Dg.				
Bl.				
L.				Geol.
K.C.				Contr.
B.K.C.				Garvey #9
Ce.				Pool
C.				Oscar So.
M.				
M.				
K.				
Mz.				
Me.				
V.				
S.				
S.				
A.				
R.				
Pe.				
G.				
T.D.				

FIRST REPORT	
	0
AUG 29 '56	

Date Comm. **8-26-56**
D 1010

9201 2 042

County Stanford Elev. 1925
 Sec. 26 Twp. 22S Rge. 11W
 Company Petroleum, Inc.
 Farm Name Smith "J" No. 3

TOPS	DEPTH	LOG	DATUM	Loc. in Sec.
Anh.	010			NW NE SE
Tr.				
H.	3307			800 EL
Tr.				
Dg.				
Bl.	3438			
L.	3450			
K.C.				Geol.
B.K.C.				Contr.
Ce.				Garvey #9
C.	3710			
M.				Pool
M.				Oscar So.
K.				
Mz.				
Mq.				
V.	3726			
S.				
S.				
A.	3811			
R.				
PE				
G.				
TD.	3836			

COMPLETE

OCT 24 '56

Date Comm. 8-26-56 85/8 301/225
 D 1010 SER 5 '56 DST 3600-20 1hr
 G/29" rec 130' G CWM BHP
 950/30" DST 3811-16 1hr. rec
 1500' OCW + 100' Wt BHP 850
 120 D 3831 SEP 12 '56 DST 3565-3655
 1hr G/55" 60' GCM + 360'
 HOCM 900/30" 5 1/2 @ 3755
 1100 8/3649-51 12/3636-39
 +5 + 1 1/2 BFP 7020 Wt 12/12

\$ 14 B Fph 40% wtr

5 hrs. SEP 19 '56 Pot SEP 26 '56 P.

53 BF 40% wtr 24 hrs

OCT 7 '56 OCT 10 '56 OCT 17 '56 ^{est.} 1170

B Fpd 40% wtr wo

Pot OCT 22 '56 Ph P. 141 B Fpd

35% wtr.