


Section 26 Township 22 Range 34W

Well No. #1 Anderson

Company Northern Pump

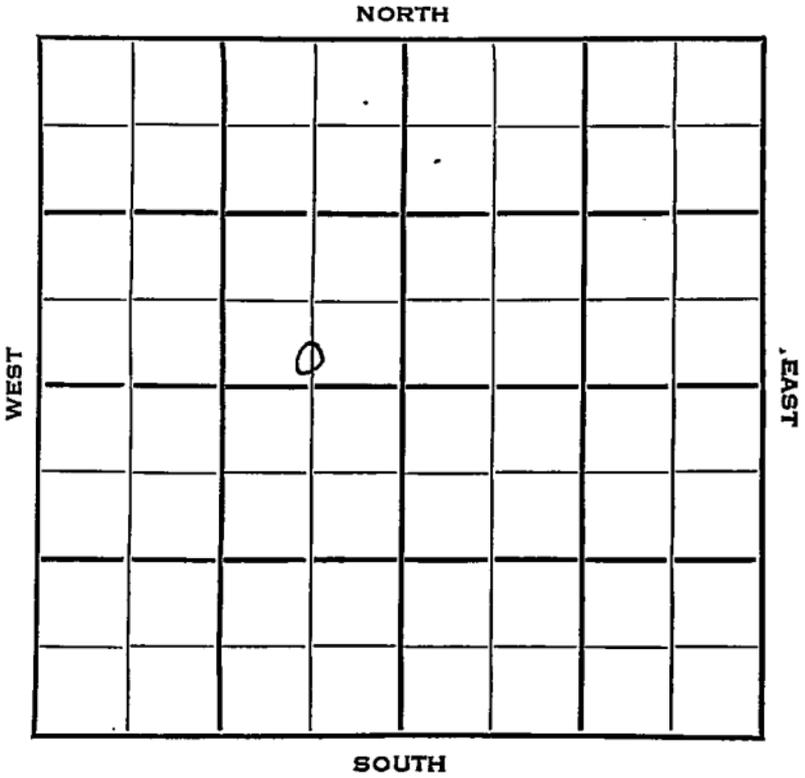

Finney

KANSAS


SEC. 26	TWP. 22	R. 34W
------------	------------	-----------

WELL NO. \_\_\_\_\_  
 - #1 Anderson FARM

COMPANY \_\_\_\_\_  
 Northern Pump  
 CONTRACTOR \_\_\_\_\_

Hugoton Pool

\_\_\_\_\_ Ft. from N. Line  
 100 \_\_\_\_\_ Ft. from S. Line  
 500 \_\_\_\_\_ Ft. from E. Line  
 \_\_\_\_\_ Ft. from W. Line

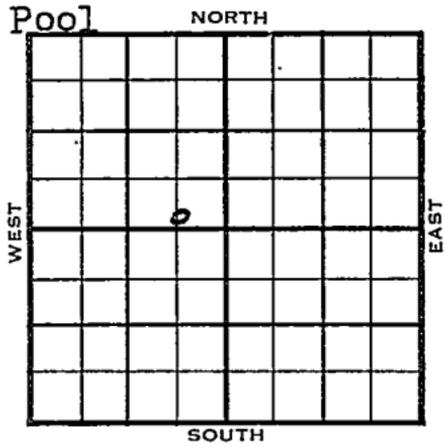

C S $\frac{1}{2}$  S $\frac{1}{2}$  SE NW

1954 ELEVATION 2938' REPORT

1/13 Spud 1-8-54  
 10" @ 313'  
 Drlg 1400'

1/20 RTD 2620' 7" @ 2616 Hol 2536'  
 Her 2554' Kr 2576' Win 2615'

3/10 Spud 1-8-54  
 Gas Well  
 TD 2626'  
 10" @ 313'  
 Hol. 2536', Her. 2554', Kri 2576',  
 Win 2615'  
 TD 2620'  
 7" @ 2616'  
 CO to 2616, DD 2626  
 Dol-frac,  
 PB 2610 39/2566-79, 48/2588-2604,  
 Dol-frac 1 m wet gas  
 PB 2605 frac  
 CO 2604 frac  
 CO 2626  
 Comp. 2,500,000 gas, 403#

COMPLETED




County Finney State Kansas

Sec. 26 (Blk. 22) (Sur. Rge.) 34W Map No.

Operator Northern Pump

Well No. 1 Farm Anderson

Elev. 2938 Location C S  $\frac{1}{2}$  S  $\frac{1}{2}$  SE NW

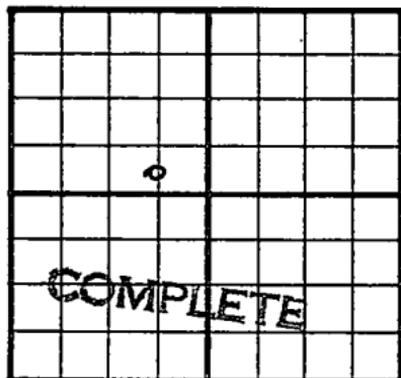

100 Ft. From S Line NW

500 Ft. From E Line Quarter

Ist. Report

Completion MAR 10 1954

Remarks Hugoton Pool

Spudding Date 1-8-54

Drlg. Data Gas well TD 2626

10" @ 313 Hol. 2536 Her. 2554

Kri. 2576 Win. 2615 TD 2620 7" @ 2616

CO to 2616 DD 2626 dol-frac PB 2610

39/ 2566-79 48/ 2588-2604 dol-frac

1 m wet gas PB 2605 frac CO 2604

frac CO 2626 Comp. 2,500,000 gas 403#