

# KANSAS


Finney

FORM 51 5M BR1X

Section 26 Township 22 Range 34W

Well No. #1, T. Miller

Company Carter Oil

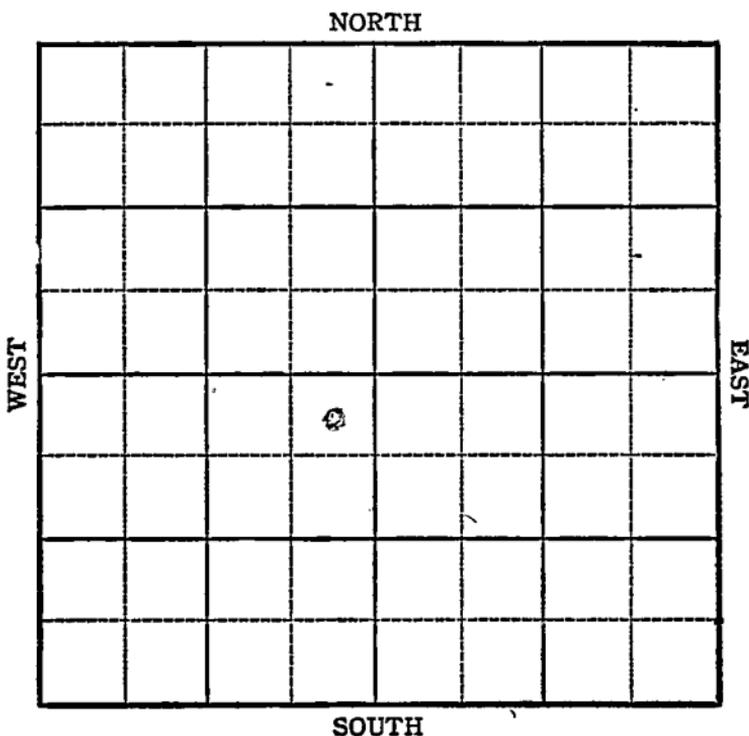

Sec. 26 Twp. 22 R. 34 W

Well No. #1, T. Miller Farm  
Carter Company


Wildcat

330 Ft. from N. Line

         Ft. from S. Line

330 Ft. from E. Line

         Ft. from W. Line

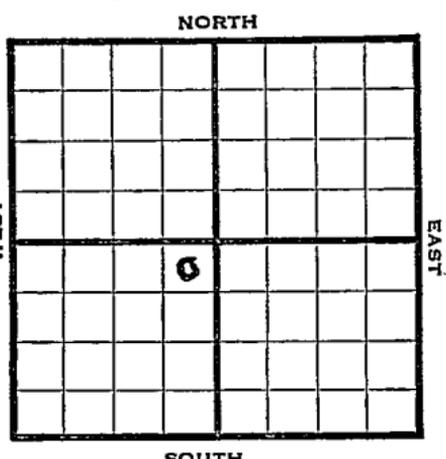

*Elev. 2938*

1944

REPORT

- 5/31 Location
- ~~6/7~~ " "
- 6/15 " "
- 6/21 " "
- 6/28 " "
- 7/12 Anhy 2012 Chase 2525  
7" @ 2608 Show gas
- 7/19 2653'  
368,000 Gas  
Drill deeper
- 7/26 Herrington 2601 TD 2830  
Krider 2663  
Winfield 2719  
Ft. Riley 2802  
TD 2830  
735000 gas SW.
- 8/2 PB 2800
- 8/9 PB 2633 8500 acid 625,000 Gas.
- 8/16 " " " " " " "
- 8/23 Herrington 2601  
Krider 2663  
Winfield 2719  
7" @ 2608  
PB 2633 - T.D. 2930  
8500 acid  
971200 c.f. Gas

COMPLETED

**KANSAS**Pool Name WildcatMap No. MM Sec. 26 Twp. 22 R. 34 WWell No. 1 T. MillerCarter


Company

**FIRST REPORT**

Contractor

NE SW

## SECTION PLAT

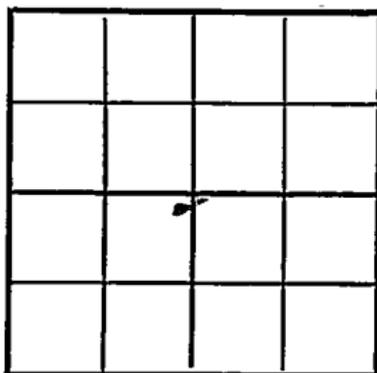330 Ft. from N. Line       Ft. from S. Line330 Ft. from E. Line       Ft. from W. LineFinney countyLocation XRig up       

Drilling and Remarks:

## RECORD

Cased        in.,        ft.Sand       Gas       Oil       Total Depth       

## PRODUCTION

1st 24 hrs. Nat.       1st 24 hrs. after shot       Gas        Cu. Ft.Dry Hole       Abandoned       

Date

MAY 31 1944 19.S. J. LEWIS

Scout

Pool Name Wildcat

Map No. MM Sec. 26 Twp. 22 R. 34W

Well No. 1 T. Miller

Carter Company

**COMPLETED** Contractor

NE SW

SECTION PLAT

330 Ft. from N. Line

\_\_\_\_\_ Ft. from S. Line

330 Ft. from E. Line

\_\_\_\_\_ Ft. from W. Line

	e		

Finney County

Location \_\_\_\_\_

Rig up \_\_\_\_\_

Drilling and Remarks:

974,210

RECORD

Cased \_\_\_\_\_ in., \_\_\_\_\_ ft.

Sand \_\_\_\_\_

Gas \_\_\_\_\_

Oil \_\_\_\_\_

Total Depth 2830

PRODUCTION

1st 24 hrs. Nat. \_\_\_\_\_

1st 24 hrs. after shot \_\_\_\_\_

Gas \_\_\_\_\_ Cu. Ft.

Dry Hole \_\_\_\_\_

Abandoned \_\_\_\_\_

Date

AUG 23 1944

S. J. LEWIS Scout