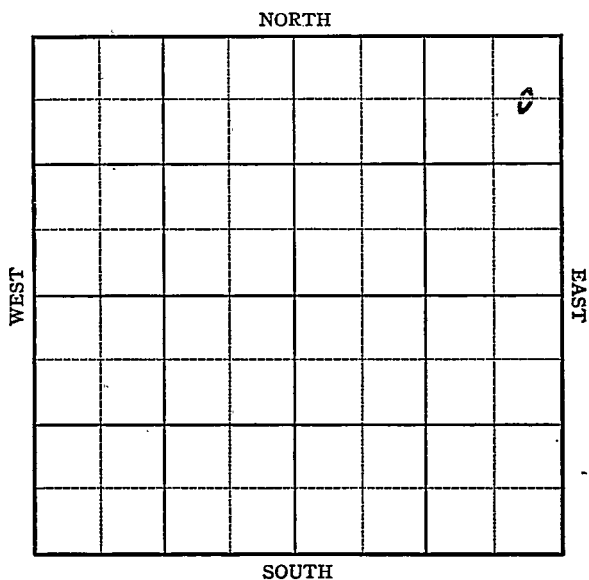


KANSAS**Kearny**

FORM 51 5M 4-41 PETROL

Section 26 Township 22 Range 38 -WWell No. #1 NiblockCompany Stanolind

KANSAS


Kearny

Sec. 26 Twp. 22 R. 38-WWell No. #1 Niblock FarmStanolind Company

(Patterson)

660 Ft. from N. Line Ft. from S. Line330 Ft. from E. Line Ft. from W. Line

Elev. 3323

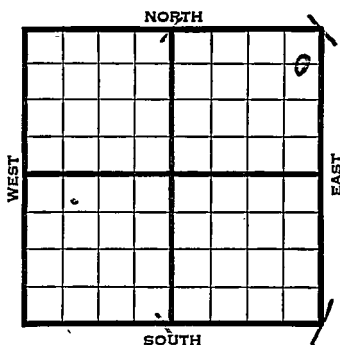

1941	REPORT
10/29	Derrick.
11/6	16" - 256' Drlg. 1090'
11/13	10" - 669' Drlg. 2265'
11/20	Drlg. 3691'
11/28	Drlg. 4002'
12/4	Lans. 4094' Drlg. 4639'
12/11	Patterson 4735
	5" @ 4736 TD RUST
12/18	Patterson 4727 (Corrected)
12/24	Drlg. 4885' No shows.
12/31	Miss. 4852' T.D. 4945'
	500' water. P.B.
1942	
1/8	P.B. to 4751'
	Shut down.
1/15	P.B. to 4669'
	Shut down.
1/22	" "
1/29	P.B. to 2816'
2/5	P.B. to 2720' WOC.
2/12	P.B. to 1940'
	OVER

1942

2/19 Ripped csg. 1900-10' $8\frac{1}{2}$ M air
mostly Nitrogen. 1200# rock pressure.

2/26 " " "

3/5 P.B. to 1707'
Shut down.

3/11 Miss. 4852'
5" - 4728'
T.D. 4945'

ABANDONED

Kearny

KANSAS

Map No. NM Sec. 26 Twp. 22 R. 38WWell No. 1 NiblockStanolind


Company

FIRST REPORT

Contractor

C EL NE NE

SECTION PLAT

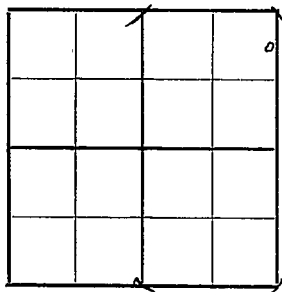660 Ft. from N. Line Ft. from S. Line330 Ft. from E. Line Ft. from W. Line

PATTERSON POOL

Location Rig up

Drilling and Remarks:

Derrick

RECORD

Cased in., ft.Sand Gas Oil Total Depth

PRODUCTION

1st 24 hrs. Nat. 1st 24 hrs. after shot Gas Cu. Ft.Dry Hole Abandoned

Date

OCT 29 1941 19S. J. LEWIS

Scout

Kearny

KANSAS

Map No. MM Sec. 26 Twp. 22 R. 38WWell No. 1 NiblockStanolind CompanyABANDONED Contractor

C EL NE NE

SECTION PLAT

660 Ft. from N. Line Ft. from S. Line330 Ft. from E. Line Ft. from W. Line

			2

PATTERSON POOL

RECORD

Location Cased in., ft.Rig up Sand

Drilling and Remarks:

Gas Oil Total Depth 4945

PRODUCTION

1st 24 hrs. Nat. 1st 24 hrs. after shot Gas Cu. Ft.Dry Hole Abandoned

Date

MAR 1 1 1942 19

S. J. LEWIS Scout