


Section 27 Township 22 Range 12W

Well No. #1 Scheib

Company E. H. Adair

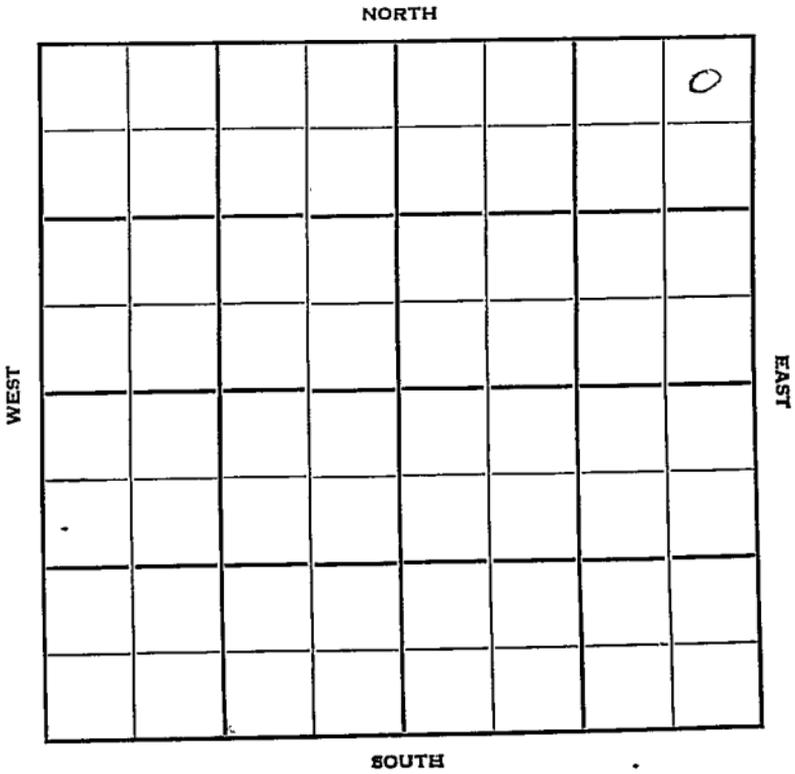

Sec. 27 Twp. 22 R. 12W-1

Well No. #1 Scheib Farm

E. H. Adair Company

Adair Contr. Contractor

Wildcat


330' Ft. from N. Line

_____ Ft. from S. Line

330' Ft. from E. Line

_____ Ft. from W. Line

NE NE NE

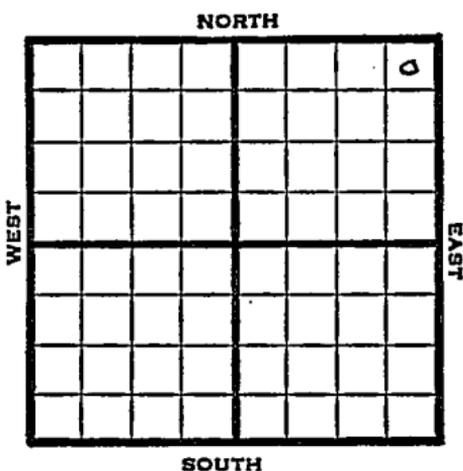

1950 Elev. 1873' REPORT

10/4 Spud 9-28-50
8-5/8" @ 278'
Anhy 645-70'
Drlg. 2080'

10/18 Spud 9-28-50
D&A TD 3703
8-5/8" @ 278'
Anhy 645-70' Top 2864'
Br Lime 3291' Lans. 3309'
Arb. 3698' TD 3703
D&
ABANDONED

County **Stafford** State **Kansas**

Sec. **27** (Blk. Twp.) **22** (Sur. Rge.) **12W** Map No.

Operator **E. H. Adair**

Well No. **1** Farm **Scheib**

Elev. **1873** Location **NE NE NE**

330 Ft. From **N** Line **NE**

330 Ft. From **E** Line Quarter

1st. Report **OCT 4 1950**

Completion

Remarks

Adair - Contr.

Spudding Date **9-28-50**

Drlg. Data **Wildcat**

8 5/8" @ 278 Anhy 645-70 drlg. 2080


County Stafford State Kansas

Sec. 27 (Blk. 22) (Sur. 12W) (Rge.) Map No.

Operator E. H. Adair

Well No. 1 Farm Scheib

Elev. 1873 Location NE NE NE

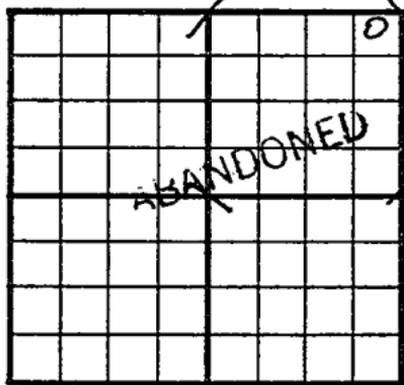

330 Ft. From N Line NE

330 Ft. From E Line Quarter

1st. Report

Completion OCT 18 1950

Remarks Wildcat

Adair - Contr.

Spudding Date 9-28-50

Drig. Data D & A TD 3703

8 5/8" @ 278 Anhy 645-70 Top. 2864

Br. lime 3291 Lans. 3309 Arb. 3698

TD 3703 D & A