


SECTION 27 TOWNSHIP 22 RANGE 12W

WELL NO. #1 Scheib

COMPANY David Bros.

NORTH

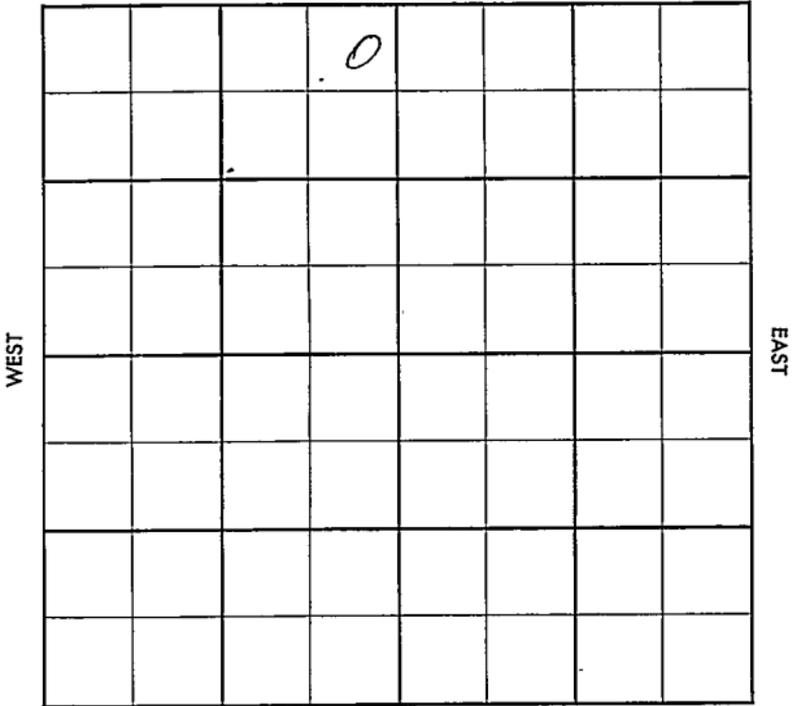

SOUTH

Stafford

KANSAS

SEC. 27	TWP. 22	R. 12W
------------	------------	-----------

WELL NO. #1 Scheib FARM

COMPANY DAVIS Bros.


CONTRACTOR Transit T
Wildcat

_____ FT. FROM N. LINE

_____ FT. FROM S. LINE

_____ FT. FROM E. LINE

_____ FT. FROM W. LINE

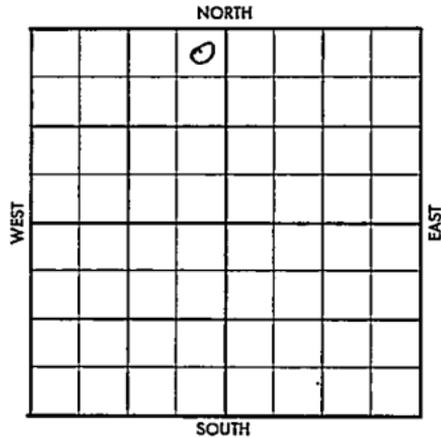

Midstates - FO

NE NE NW

1956	ELEVATION	REPORT
------	-----------	--------

905	WORT	
-----	------	--

County Stafford Elev. _____
 Sec. 27 Twp. 22 Rge. 12W
 Company Davis Bros.
 Farm Name Scheib No. 1

TOPS	DEPTH	LOG	DATUM	Loc. in Sec.
Anh.				NE NE NW
TP.				
H.				
Tr.				
Dg.				
Bl.				
L.				Geol. _____
K.C.				Contr _____
B.K.C.				Transit T. _____
Ce.				
C.				Pool _____
M.				Wildcat _____
M.				
K.				
Mz.				
Me.				
V.				
S.				
S.				
A.				
R.				
PE.				
G.				
T.D.				

0

FIRST REPORT

SEP 5 '56

Date Comm. Midstates (FO)

WORT

~~SEP 11 1956~~

~~SEP 11 1956~~

Co.
Lse.
No.
Sec.
T.
R.

County Stafford Elev. 1867
 Sec. 27 Twp. 22 Rge. 12W
 Company Davis Bros.
 Farm Name Sci. eib No. 1

TOPS	DEPTH	LOG	DATUM	Loc. in Sec.
Anh.				NE 1/4
Tp.				
H.	3154			
Tr.				
Dg.				
Bl.	3284			
L.	3304	3307		Geol.
K.C.				Contr.
B.K.C.				Transit F.
Ce.				
C.				Pool
M.				
M.				
K.				
Mz.				
Mo.				
V.	3590			<div style="border: 1px solid black; padding: 5px; text-align: center;"> <p>ABANDONED</p> <p>SEP 19 '56</p> </div>
S.	3633			
S.				
A.	3701			
R.				
Pe.				
G.				
T.D.	3711			

Date Comm. indstates (EG)

WORT SEP 12 '56 9-4-56 8578 225
1150 th 3100 SEP 13 '56 DST 3313
-60 1hr 1260' wte BHP 1260/15"
DST 3596-3677 1hr 110' WM
(550) BHP 740/15 DST 3703-11
1hr 300' wte BHP 1040/15"
DST DB PKR 3402-3514 1hr
145' WM (550) BHP 1200/15
D & A.