

Stafford


DX 78-1

KANSAS

Section 27 Township 22 Range 13W

Well No. #1 Durham

Company Beardmore Drlg.

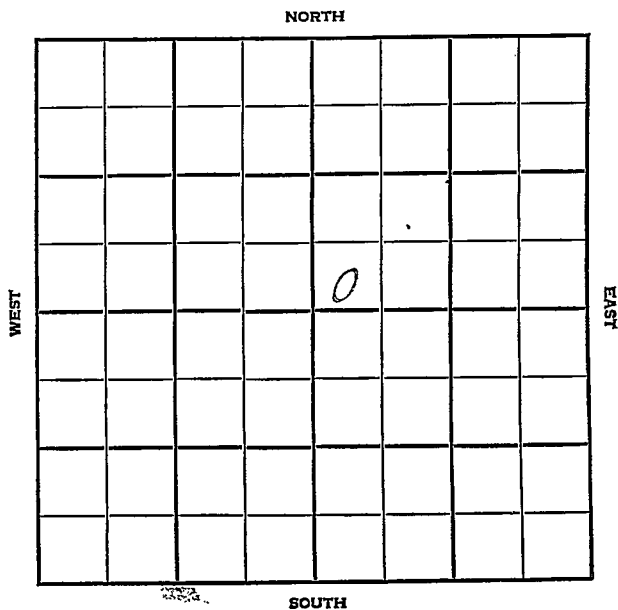

FORM 513 SUNRAY

TOPS	DEPTH	LOG	DATUM	Loc. in Sec.
Anh.				SW, SW NE
TP.				
H.				
Tr.				
Dg.				
Bl.				
L.				Geol.
K.C.				Contr.
B.K.C.				Co. tools
Ce.				Pool
C.				Wildcat
M.				
M.				
K.				
Mz.				
Me.				
V.				
S.				
S.				
A.				
R.				
Pe.				
G.				
T.D.				

NOV 21 '54

FIRST REPORT


Date Comm.

Texas - DHM

M T R

County Stafford Elev. 1895 DF
1897 1C13
 Sec. 27 Twp. 22 Rge. 13W
 Company Beardmore Drlg.
 Farm Name Durham No. 1

TOPS	DEPTH	LOG	DATUM	Loc. in Sec.
Anb.	745			SW SW NE
Tr.				
H.	3274	3274		
Tr.		3295		
Dg.				
Bl.	3408	3409		
L.	3427	3427		
K.C.				Geol.
B.K.C.		3640		Contr.
Ce.				Co. tools
C.		3708		Pool
M.				Wildcat
M.				
K.				
Mz.				
Mo.				
V.		3731		
S.		3780		
S.				
A.		3837		
R.				
PE.				
G.				
TD.	3870			

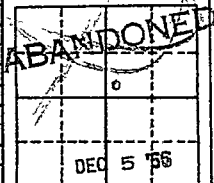

Date Comm. Texas - DHM

M I R 1225 11-21-56 85/8 314
 1225 DST 3547-3630 DEC 5 '56
 cr. 1hr rec 65' Md FPO-0 BHP
 1100/30 DST 3706-83 1hr rec
 58' Md BHP 960/30" DST 3839
 -45 1hr rec 145' sulp w/str BHP
 1240/30"

DEA