


Section 27 Township 22 Range 11W

Well No. #1 Garvin

Company Woody Speer

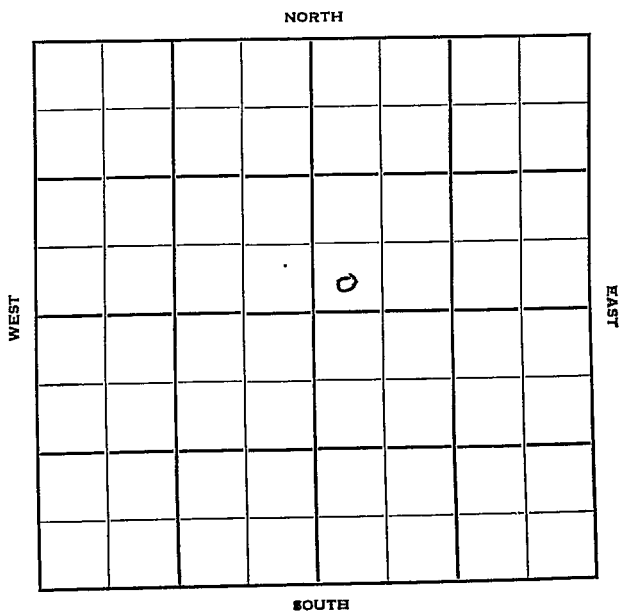

Stafford

KANSAS

Sec. 27 Twp. 22 R. 14W

Well No. #1 Garvin Farm

Woody Speer Company

M. B. Armer Contractor

Wildcat


_____ Ft. from N. Line

330 Ft. from S. Line

_____ Ft. from E. Line

330 Ft. from W. Line

NE $\frac{1}{4}$ SW SW NE
NCRA Farmout

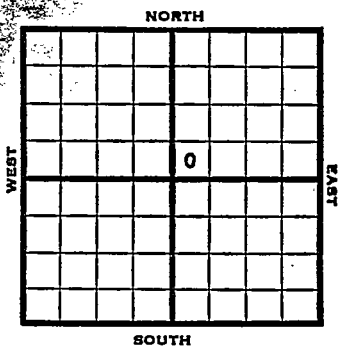

1952 Elev. 1940' REPORT

11/12 Spud 11-5-52
8" @ 324'
Drlg. 2430'

11/19 Spud 11-5-52
D&A
TD 3945'
8" @ 324'
Heeb 3357, Br. lime 3483,
Lans. 3493, Viola 3806, Simp
3857, Arb. 3914
TD 3945
D&A

ABANDONED

