


Section 27 Township 22 Range 15 W

Well No. # 2 Sutton

Company National Gas & Oil Corp. (formerly Westgate-Greenland)

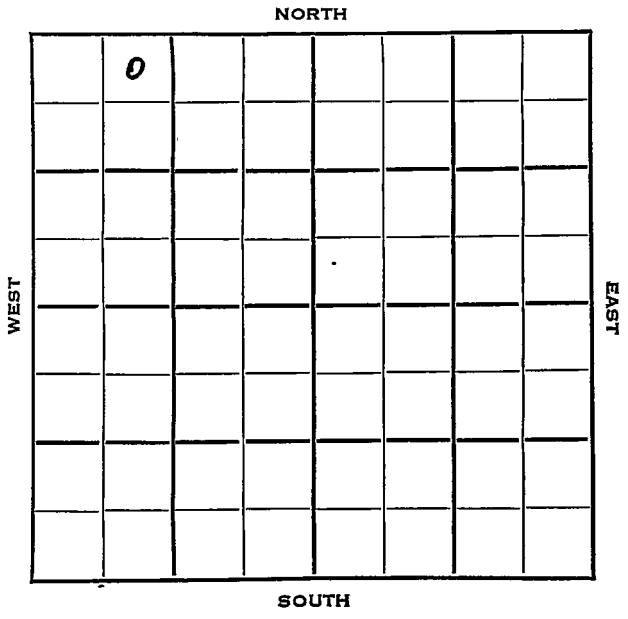

Pawnee

KANSAS ✓

Sec. 27 Twp. 22 R. 15W

Well No. #2 Sutton Farm

Natinnal Gas & Oil Corp. Company  
(Formerly Westgate & Greenland  
Nat'l Oil & Gas Contractor

Dunes Pool


330 Ft. from N. Line

\_\_\_\_\_ Ft. from S. Line

\_\_\_\_\_ Ft. from E. Line

990 Ft. from W. Line

NE NW NW

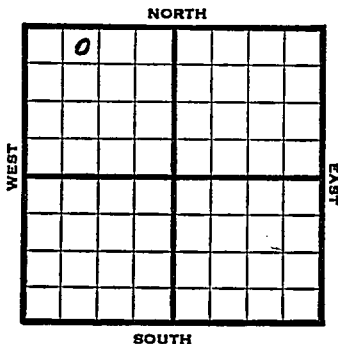

1953 Elev. 1990' REPORT

6/10 Spud 6-8-53

6/24 . RTD 3961'  
5" @ 3960'

7/1 71/3947-57

7/8 S/23 BOPH 3 hrs. POP

7/15 Spud 6-8-53

Oil Well

TD 3961

8" @ 220

Heeb 3388, Br lime 3508, Lans 3518

DST 3602-1.8, opn 1 hr., rec. 360' gas,  
20' o & gcm, 120' ho & gcw & mud

1160#

DST 3659-91, opn 1 hr., rec. 90' gcm,  
1190#

B KC 3748, Viola 3870, Arb 3945

DST 3947-56, opn 1 hr., rec. 3820'  
gassy oil, 1290#

TD 3961

5" @ 3960

71/3947-57, S/23 boph 3 hrs.

Comp. 3000 bopd

COMPLETED

County Pawnee State Kansas

Sec. 27 (Blk. Twp.) 22 (Sur. Rge.) 15W Map No.

Operator National Gas & Oil Corp. (formerly Westgate-Greenland)

Well No. 2 Farm Sutton

Elev. \_\_\_\_\_ Location NE NE NW

0					
FIRST REPORT					

330 Ft. From N Line NW

990 Ft. From W Line Quarter

Ist. Report JUN 10 1953

Completion \_\_\_\_\_

Remarks \_\_\_\_\_

Nat'l Oil & Gas - Contr.

Spudding Date 6-8-53

Drig. Data Dunes Pool

County Pawnee State KansasSec. 27 (Blk.  
Twp.) 22 (Sur.  
Rge.) 15W Map No.Operator National Gas & OilWell No. 2 Farm SuttonElev. 1990 Location NE NW NW

o					

330 Ft. From N Line NW990 Ft. From W Line QuarterIst. ReportCompletion JUL 15 1953Remarks Dunes PoolNat'l Oil & Gas - Contr.Spudding Date 6-8-53Drlg. Data Oil well TD 39618" @ 220 Heeb. 3388 Br. line 3508Lans. 3518 DST 3602-18 open 1 hr.Rec. 360' gas 20' o & gcm 120' ho & gcw& mud 1160# DST 3659-91 open 1 hr.Rec. 90' gcm 1190# B KC 3748Viola 3870 Arb. 3945 DST 3947-56open 1 hr. Rec. 3820' gassy oil 1290#TD 3961 5" @ 3960 71/ 3947-57S/ 23 boph 3 hr. Comp. 3000 bopd

J. G. McGEHEE