


Section 27 Township 22 Range 8-WWell No. #1 BeitlerCompany Atlantic

NORTH

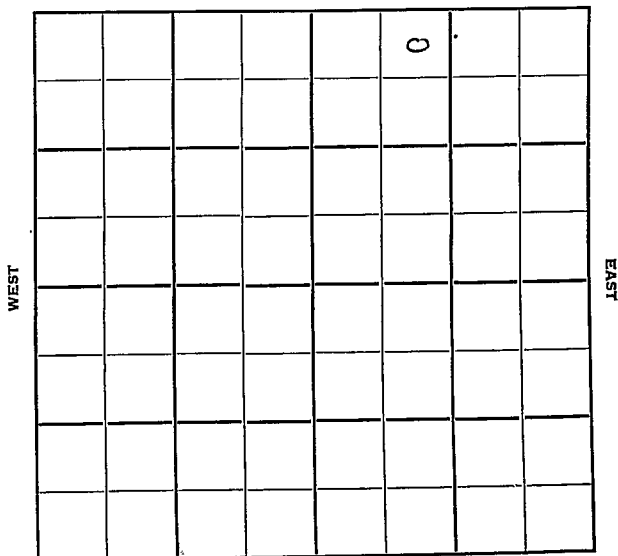

SOUTH

Reno

KANSAS

Sec. 27 Twp. 22 R. 8W

Well No. #1 Beitler Farm

Atlantic

Company

Contractor

Wildcat

330'

Ft. from N. Line


Ft. from S. Line

Ft. from E. Line

990'

Ft. from W. Line

NE NW NE

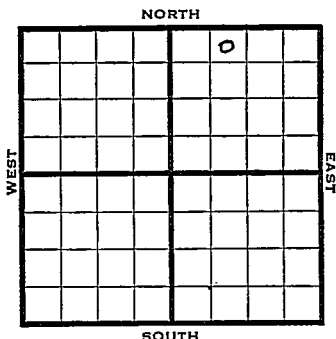

1950	Elev 1662	REPORT
8/9	MIM	
8/30	8 5/8" @ 264	
	Br lime 3072	Lans 3095
	DST 3438-62	opn 1 hr rec 6' mud
	Cong 3562	Miss 3581
	DST 3586-95	opn 1 hr rec 70' sli o&gem
	Kinderhook 3646	Miss 3870
	Viola 3882	
	DST 3884-3918	opn 40 min rec 5' mud
	Simp 3922	Arb 3991
	TD 4018	
	D&A	
	ABANDONED	

~~J. E. TYRA~~

County Reno State Kansas
 Sec. 27 (Blk. 22 (Sur. 8W Map No.)
 (Twp.) (Rge.)

Operator Atlantic

Well No. 1 Farm Beitler

Elev. 1662 Location NE NW NE

330 Ft. From N Line NE

990 Ft. From W Line Quarter

1st. Report

Completion AUG 30 1950

Remarks Core drill

Wildcat

Spudding Date

Drlg. Data D & A TD 4018

8 5/8" @ 264 Br. lime 3072 Lans. 3095

DST 3438-62 open 1 hr. Rec. 6' mud

Cong. 3562 Miss. 3581 DST 3586-95

open 1 hr. Rec. 70' Sli o & gcm

Kinderhook 3646 Miss. 3870 Viola 3882

DST 3884-3918 open 40 min. Rec. 5' mud

Simp. 3922 Arb. 3991 TD-4018

D& A

J. E. TYRA