

Section 27 Township 22 Range 10W

Well No. 1 Withroeder

Company R.J. Woelk

Wildcat
NORTH

WEST

EAST

SOUTH

KANSAS

Reno

Sec. 27 Twp. 22 R. 10W

Well No. #1 Withroeder Farm

R. J. Woelk Company

Wildcat


330' Ft. from N. Line

 Ft. from S. Line

 Ft. from E. Line

330' Ft. from W. Line

NW NE

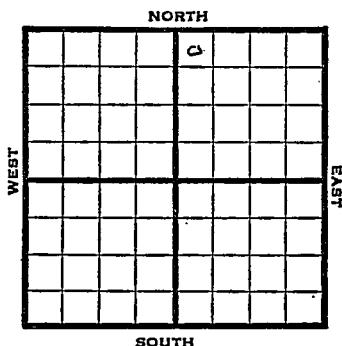

1948

Eli 1755'

REPORT

9/15

8" @ 278'

WOC

9/21

Lansing 3204'

Drig. 3355'

9/28

TD 3705'

Lans. 3204'

Viola 3553'

Simp Sd 3598'

Arb. 3651'

Aband.

ABANDONED

Reno County Kansas State

Map No. _____ Sec. 27 Twp. 22 R. 10W

Well No. 1 Withroeder

R. J. Woelk Company

FIRST REPORT

Contractor

NW NE


SECTION PLAT

330 Ft. from N. Line

_____ Ft. from S. Line

_____ Ft. from E. Line

330 Ft. from W. Line

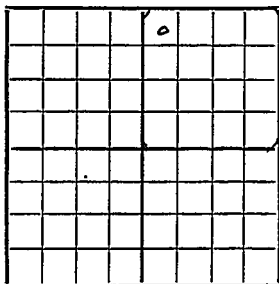

Wildcat

Remarks:

8" @ 278 WOC

Date

SEP 15 1948.

Scout


S. J. LEWIS

Map No. 46 Sec. 27 Twp. 22 R. 10WWell No. 1 WithroederR. J. Woelk Company

ABANDONED

Contractor

NW NE

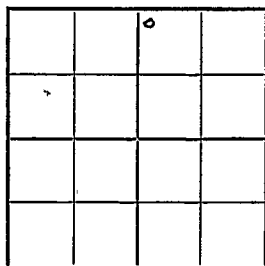E 1175-5
SECTION PLAT330 Ft. from N. Line Ft. from S. Line Ft. from E. Line330 Ft. from W. Line

Reno County

Location Rig up

Drilling and Remarks:

Lane 3204
Wick 3553
Sing. Sol. 3098
Ar. & 3651

RECORD

Cased in., ft.Sand Gas Oil Total Depth 3703

PRODUCTION

1st 24 hrs. Nat. 1st 24 hrs. after shot 3174Gas Cu. Ft.Dry Hole Abandoned

Date

SEP 29 1948

19

S. J. LEWIS

Scout