

Well No. #1 Doyle

Company Trans-Era & Palmer Oil Company

NORTH

WEST

EAST

SOUTH

Finney

KANSAS ✓

Sec. 27 Twp. 22 R. 30W

Well No. #1 Doyle Farm

Trans-Era & Palmer Oil Company


Contractor

330 Ft. from N. Line

_____ Ft. from S. Line

330 Ft. from E. Line

_____ Ft. from W. Line

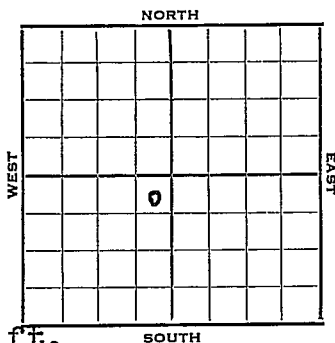

NE NE SW

Sun - DHM

Texas - \$1.00 per ft.

1953 Elev. 2812' REPORT

2/18 Spud 2-14-53

8" @ 249

2/26 Drlg. 2385

3/12 Hol 2591, Her 2624, Up Kr 2648,
Low Kr 2680

DST 2696-2731, 1 hr., 80' M

425#

Ft. Riley 2781, Heeb 3953,

KC 3999

Drlg. 4675'

3/18 Spud 2-14-53 D & A TD 4856'

8" @ 249 Hol. 2591 Her. 2624

Kri. 2648'

DST 2696-2731 open 1 hr. rec 80' mud

425# Ft. Riley 2781 Heeb 3953

KC 3999 Marm 4353 Cherokee 4568


Miss 4674 St. Louis 4716

TD 4856' D & A

ABANDONED

J. G. McGEHEE

County Finney State Kansas
 Sec. 27 (Blk.) 22 (Sur.) 30W Map No. _____
 Operator Trans-Era & Palmer Oil
 Well No. 1 Farm Doyle
 Elev. 2812 Location NE NE SW

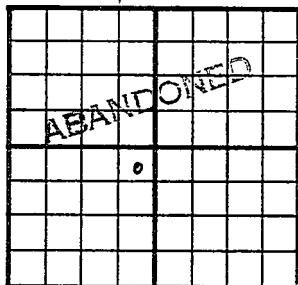

330 Ft. From N Line SW
330 Ft. From E Line Quarter

1st. Report

Completion MAR 18 1953

Remarks

Spudding Date 2-14-53

Drig. Data D & A TD 4856

8" @ 249 Hol. 2591 Her. 2624 Kri. 2648

DST 2696-2731 open 1 hr. Rec. 80' mud

425# Ft. Riley 2781 Heeb. 3953

KC 3999 Marm. 4353 Cherokee 4568

Miss. 4674 St. Louis 4716 TD 4856

D & A