


Finney

SECTION 27 TOWNSHIP 22 S RANGE 32 W

WELL NO. # 1 G. G. Strasser

COMPANY Texas Co.

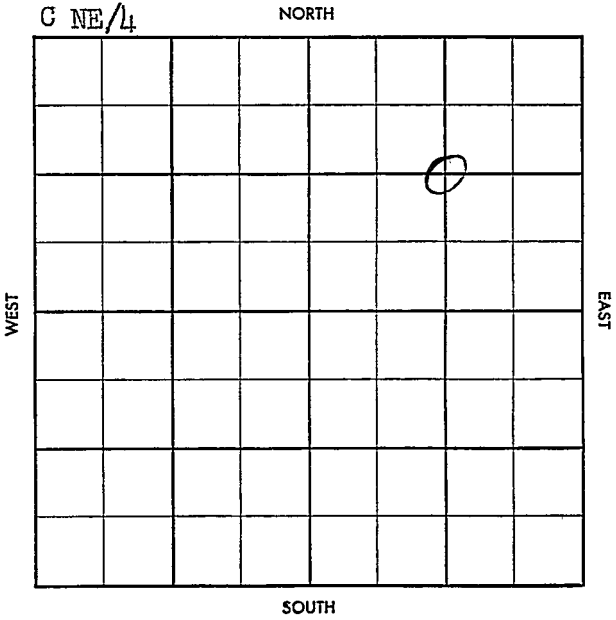

SEC. 27 TWP. 22 S R. 32 W

WELL NO.

#1 Strasser Unit

FARM

COMPANY

Texas Company (DEVELOPMENT-OB^{OC})

CONTRACTOR

Hugoton Area

1320 FT. FROM N. LINE

_____ FT. FROM S. LINE


1320 FT. FROM E. LINE

_____ FT. FROM W. LINE

of NE/4

C NE/4

SDX-1/4 ~~Interest~~

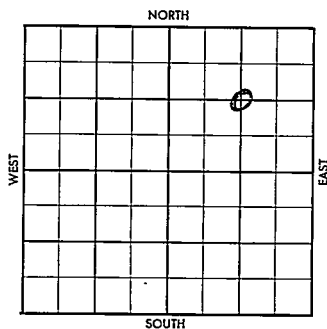

ELEVATION

REPORT

1957

2800' Permian Test
 10/16 Location (FR Tkt)
 10/18 8-5/8" @ 519'
 TD 519' WOC (DR#204)
 10/21 Spudded 10-16-57
 Drlg. 750'
 10/22 TD 2766'. WOC. 5 1/2" @ 2766'
 10/23 TD 2766' WOC. 5 1/2" csg.
 10/24 TD 2766' WOC. 5 1/2" csg.
 10/25 TD 2766' WOCT
 10/28 TD 2766' RUCT
 10/29 TD 2766' Flowed 3965 MCF.
 Perfs 2687-2694' Permian Zone
 Complete (DR#211)

32

S-513-A

CO. Finney ELEV. _____
SEC 27 TWP. 22 RGE. 32W
COMPANY Texas Co. NO. 1

OCT 16 57
FLOW REPORT
SDX - 1/4 INT

FARM C. G. Strasser

LOC. C NE/4

GEOL. _____
CONTR. _____
POOL Hugoton
SPUD _____
Location _____

CO.
LSE.
NO.
SEC.
TWP.
RGE.

08

S 513-A

~~Finney~~

~~Sec 27~~

ELEV 2741.0

RGE 32W

NOV 6 '57

COMPANY U.S. 23

NO. 1

COMPLETE

SDX-KENT

FARM J. G. Strasser

LOC. C 1/4

GEOL.

CONTR.

POOL Harriet

SPUD 10-16-57

LOC.

5/8 519/350

TD 2766 GRNL

5 1/2" 2766/100 WOC

Log Hol 2659

Her 2672 krider

2682 Win 2750 RTD 2766

5" 2766 CO 2707

Perf 48/2687-94 \$ dry

test 23 MCF test 63 MCF

snoc 3x3 flush with 76 BW

\$ down ga 3,965 MCF 40 BW ph

ga 2,956 MCF dry SI for 72-30

X 6.090 MCF

SIP 3902

CO. LSE. NO. SEC. TWP. RGE.