


Finney KANSAS

DX 78-1

Section 27 Township 22 Range 33W

Well No. 1 Adams

Company W. L. Hartman

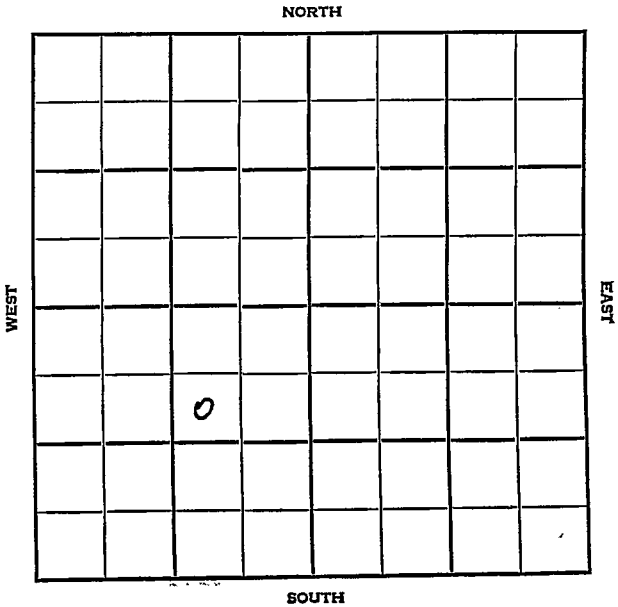

Finney

KANSAS

SEC.	TWP.	R.
27	22	33 W ✓

WELL NO.

1 Adams

FARM

COMPANY

W. L. Hartman

CONTRACTOR

H & H

Finnup Pool


990 Ft. from N. Line

Ft. from S. Line

990 Ft. from E. Line

Ft. from W. Line

SW NE SW

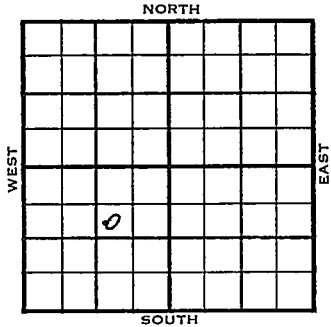

Champlin F/O

	ELEVATION	REPORT
1954	2883	
6/23	MIR	
6/30	10" @ 289 w/200 Hol 2494' Her 2519 K. 2544 O'Dell 2561 Win 2578' Gauge 2607' Up Fort 2626' RTD 2655 7" @ 2655	
7/21	NR	
8-11	Spdg 6-17-54 Gas well TD 2655 10" @ 289 Hol 2494 Her. 2519 Kri. 2544 Odell 2561 Win, 2578 Ft. Riley. 2626 TD 2655 7" @ 2655 GO to 2613 96/ 2582-2606 250-A sd-frac 1000 A 1,460,000 cfg PB 2567 500 A sd-frac 2000 A 5, 170, 000 cfg GO to 2613 2000 A Comp. 21, 000,000 cfgpd	

COMPLETED

County Finney State Kansas

Sec. **27** (Blk. Twp.) **22** (Sur. Rge.) **33W** Map No.

Operator **W. L. Hartman**

Well No. 1 Farm Adams

Elev.	Location	SW	NE	SW
-------	----------	----	----	----

990 Ft. From N Line SW

990	Ft. From	E Line	Quarter
-----	----------	--------	---------

1st. Report **JUN 23 1954**

Completion.

Remarks Champlin farmout

H & H - Contr.


Spudding Date

Drbg. Data Finnup Pool

MIR

J. G. McGEHEE

County Finney State Kansas
 Sec. 27 (Blk.) 22 (Sur.) 33W Map No.
 Operator W. L. Hartman
 Well No. 1 Farm Adams
 Elev. 2883 Location SW NE SW

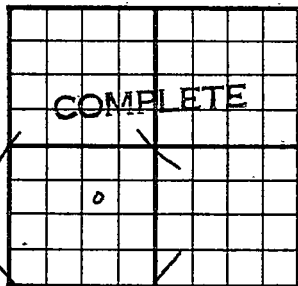

990 Ft. From N Line SW
990 Ft. From E Line Quarter
 Ist. Report AUG 11 1954
 Completion
 Remarks Finnup Pool
H & H - Contr.
 Spudding Date 6-17-54

Drlg. Data Gas well TD 2655
10" @ 289 Hol. 2494 Her. 2519
Kri. 2544 Odell 2561 Win. 2578
Ft. Riley 2626 TD 2655 7" @ 2655
CO to 2613 96/ 2582-2606 250 A
sd-frac 1000 A 1,460,000 cfg PB 2567
500 A sd-frac 2000 A 5,170,000 cfg
CO to 2613 - 2000 A
Comp. 21,000,000 cfgpd

7/2