


Section 27 Township 22 Range 33 W
Well No. # 1 Ed R. Adams
Company Champlin Ref.

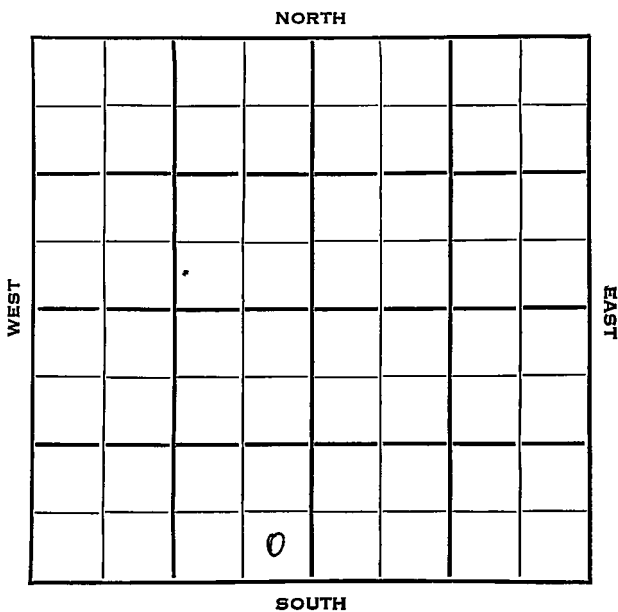

Finney

KANSAS

SEC.	TWP.	R.
27	22	33 W ✓

WELL NO.

1 Ed R. Adams

FARM

COMPANY

Champlin Ref.

CONTRACTOR

Champlin

Finnup Pool


Ft. from N. Line

330 Ft. from S. Line

330 Ft. from E. Line

Ft. from W. Line

SE SE SW

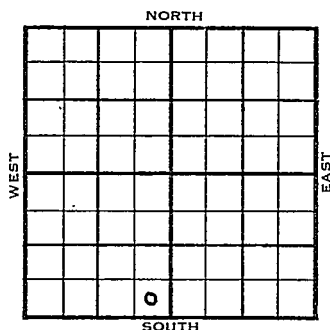

	ELEVATION	REPORT
1953	2888'	
12/16	RUR	Deep Test
1954		
1/6	Heeb 3810', Lans 3850' B KC 4330' Marm 4353', DST 4395'-4417' 1 hr, 22' M 325# DST 4556'-96' 1 hr, 15' M Dr1g 4648'	
2/24	Spud 12-14-53 Oil well TD 4897' 10" @ 352 Heeb 3810 Lans 3850 B KC 4330 Marm 4353' DST 4395-4417 open 1 hr rec 22' mud 325# DST 4556-96 open 1 hr rec 15' mud 0# DST 4770-85 open 1 hr rec 3150' gas, 570' oil 750# DST 4790-4871' open 1 hr rec 40' mud 1025# TD 4897 7" @ 4896 Cherokee 4480 St. Gen 4712' St. Louis 4769 CO to 4827' 48/4773-81 S/4 1/2 BOPH 7 hr. P/130 BO 16 hr. Comp. 131 BOPD	
COMPLETED		

County Finney State Kansas

Sec. 27 (Blk. Twp.) 22 (Sur. Rge.) 3 SW Map No.

Operator Champlin Ref.

Well No. **1** Farm **Ed R. Adams**

Elev.	Location	SE SE SW
-------	----------	----------

FIRST REPORT

330 Ft. From S Line SW

330 Ft. From E Line Quarter

1st. Report DEC 16 1953

Completion

Remarks Deep test


Champlin - Contr.

Spudding Date

Drig. Data Finnup Pool

BER

County Finney State Kansas
 Sec. 27 (Blk.) 22 (Sur.) 33W Map No.
 Operator Champlin Ref.
 Well No. 1 Farm Ed R. Adams
 Elev. 2888 Location SE SE SW

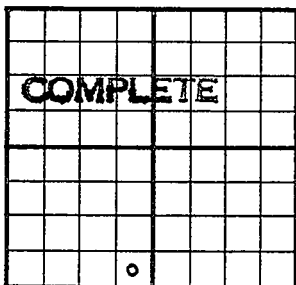

330 Ft. From S Line SW
330 Ft. From E Line Quarter

1st. Report

Completion FEB 24 1954

Remarks Finnup Pool
Champlin - Contr.

Spudding Date 12-14-53

Drlg. Data Oil well TD 4897

10" @ 352 Heeb. 3810 Lans. 3850

B KC 4330 Marm. 4353 DST 4395-4417

open 1 hr. Rec. 22' mud 325#

DST 4556-96 open 1 hr. Rec. 15' mud

0# DST 4770-85 open 1 hr. Rec. 3150'

gas 570' oil 750# DST 4790-4871

open 1 hr. Rec. 40' mud 1025#

TD 4897 7" @ 4896 Cherokee 4480

St. Gen. 4712 St. Louis 4769

CO to 4827 48/ 4773-81 S/ 4 $\frac{1}{2}$ boph 7 hr.

P./130 bo 16 hr. Comp. 131 bopd

J. G. McGEHEE