

Finney

DX 78-1

KANSAS

Section 27 Township 22 Range 33W

Well No. #1 Crozier

Company W.L. Hartman

NORTH

WEST

EAST

				0			

SOUTH

SEC.	TWP.	R.
27	22	33W

WELL NO.

#1 Crozier

FARM

COMPANY

W.L. Hartman

CONTRACTOR

Hartman

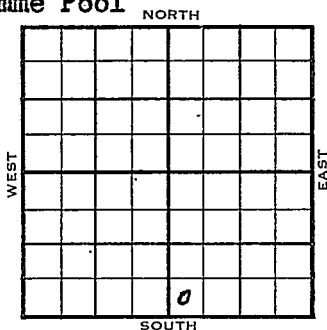
S. Damme Pool

Ft. from N. Line

330 Ft. from S. Line

Ft. from E. Line

330 Ft. from W. Line



SW SW SE

ELEVATION

REPORT

1954

4/27

Spud 4-23-54

8" @ 282'

Drlg 2120'

5/5

Drlg. 3700'

5/12

Hol 2497', Her 2522', Kr 2545', Win 2579', Up Ft. 2634', Low Ft 2706', Heeb 3809', Lans 3849', B KC 4321', Marm. 4350'

Drlg. 4386'

5/19

Cher 4473', Miss 4686'

Drlg 4734'

5/26

Drlg. 4921'

6/2

Drlg. 5256'

6/9

RTD 5700'

8/25

Spud 4-23-54 Oil well TD 5700

8" @ 282 Hol. 2497 Her. 2522

Kri. 2545 Win. 2579 Ft. Riley 2634

Heeb 3809 Lans. 3849 B KC 4321

Marm. 4350 Cherokee 4473 Miss 4686

Osage 5065 Kh. 5294 Viola 5412

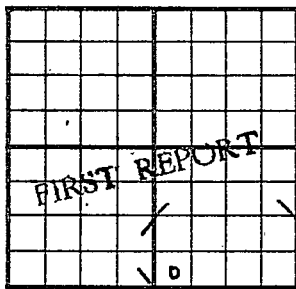
TD 5700 5" @ 4830 Arb. 5582

S/1 BOPH 1000 A Perf/4769-73

1000 A 31 BOPH 5 hr. S/45 BOPH

Comp. 182 BOPD

COMPLETED

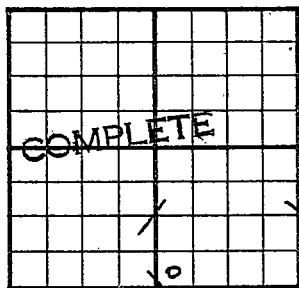
County Finney State KansasSec. 27 (Blk. Twp.) 22 (Sur. Rge.) 33W Map No.Operator W. L. HartmanWell No. 1 Farm CrozierElev. Location SW SW SE330 Ft. From S Line SE330 Ft. From W Line Quarter1st. Report APR 27 1954

Completion

Remarks

Hartman - Contr.Spudding Date 4-23-54Drlg. Data S. Danne Pool8" @ 282 drlg. 2120

J. G. McGEHEE

County Finney State KansasSec. 27 (Blk. 22) (Sur. 33W) Map No. 33WOperator W. L. HartmanWell No. 1 Farm CrozierElev. 2883 Location SW SW SE330 Ft. From S Line SE330 Ft. From W Line Quarter1st. Report Completion AUG 25 1954Remarks S. Damme PoolHartman - Contr.Spudding Date 4-23-54Drilg. Data Oil well TD 57008" @ 282 Hol. 2497 Her. 2522Kri. 2545 Win. 2579 Ft. Riley 2634Heeb. 3809 Lans. 3849 B KC 4321Marm. 4350 Cherokee 4473 Miss. 4686Osage 5065 Kh. 5294 Viola 5412TD 5700 5" @ 4830 Arb. 5582S/ 1 boph 1000 A perf/ 4769-731000 A 31 boph 5 hr. S/ 45 bophComp. 182 bopd

FABEN GILSTRAP