

KANSAS


FORM 51 5M 4-41 PETROL

Stafford

Section 28 Township 22 Range 13-W

Well No. #1 B. Shotton

Company Zephyr Drilling

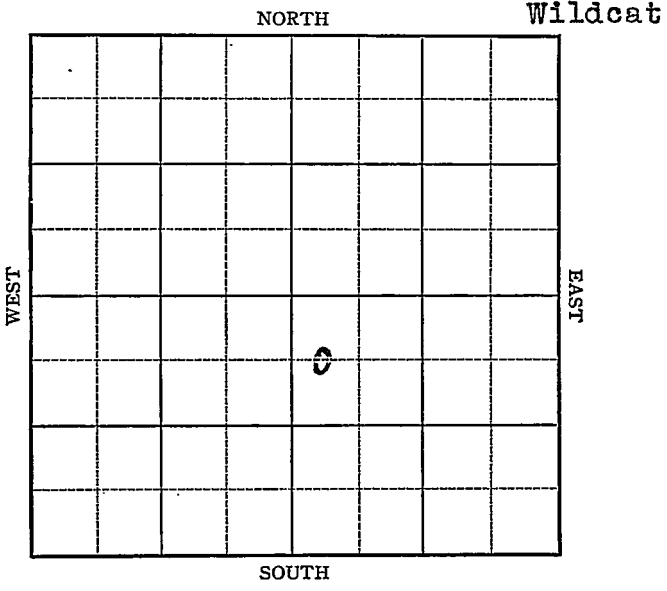

Sec. 28 Twp. 22 R. 13 -W

Well No. #1 B. Shotton Farm

Zephyr Drilling Company


(Wild cat)

660 Ft. from N. Line

_____ Ft. from S. Line

_____ Ft. from E. Line

330 Ft. from W. Line

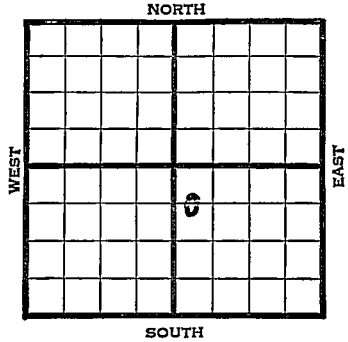

Elev. 1903

1941

REPORT

4/16

Moving in rotary.

5/1

Top Arbuckle 3853 small show oil

Going in to core (Tel)

5/1

Topeka 3020' Lans. 3445'

Viola 3740' Drilg. 3772'

5/1

Top Arbuckle 3853' small show oi

Going in to core. (Tel)

5/8

T.D. 3885' water.

Shut down.

5/14

Arb. 3853'

T.D. 3900'

Water.

ABANDONED

Map No. 82 Sec. 28 Twp. 22 R. 13W

Well No. 1 B. Shotton

Zephyr Drilling Company

Contractor

SECTION PLAT

C W L NW SE

660 Ft. from N. Line

_____ Ft. from S. Line

_____ Ft. from E. Line

330 Ft. from W. Line

		•	

WILDCAT

Location _____

Rig up _____

Drilling and Remarks:

Moving in Roty.

RECORD

Cased _____ in., _____ ft.

Sand _____

Gas _____

Oil _____

Total Depth _____

PRODUCTION

1st 24 hrs. Nat. _____

1st 24 hrs. after shot _____

Gas _____ Cu. Ft.

Dry Hole _____

Abandoned _____

Date

APR 16 1941

S. J. LEWIS

Scout

Map No. 82 Sec. 28 Twp. 22 R. 13WWell No. 1 B. ShottonZephyr Drilling CompanyABANDONED Contractor

SECTION PLAT

C W L NW SE

660 Ft. from N. Line

_____ Ft. from S. Line

_____ Ft. from E. Line

330 Ft. from W. Line

		o	

WILDCAT

Location _____

Rig up _____

Drilling and Remarks:

*CU 83853**Water*

RECORD

Cased _____ in., _____ ft.

Sand _____

Gas _____

Oil _____

Total Depth 3900

PRODUCTION

1st 24 hrs. Nat. _____

1st 24 hrs. after shot _____

Gas _____ Cu. Ft.

Dry Hole _____

Abandoned _____

Date

MAY 14 1941 19S. J. LEWIS Scout