


Section **28** Township **22** Range **13W**

Well No. **#1 Walls (B)**

Company **Petroleum Inc.**

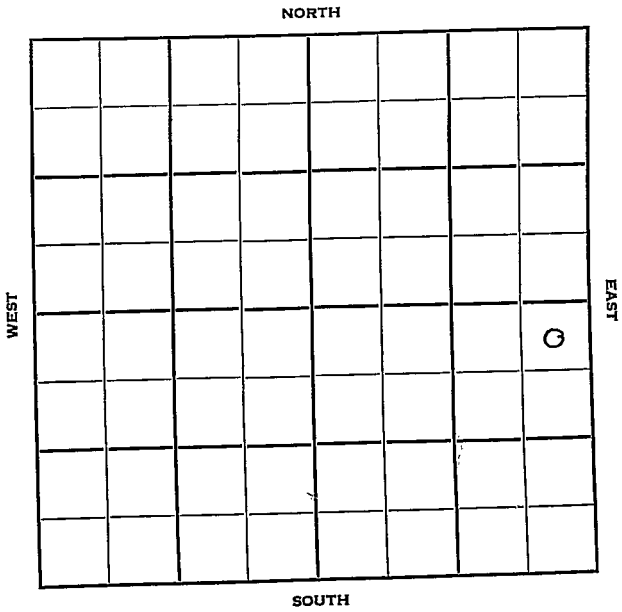

Sec. 28 Twp. 22 R. 13 W

Well No. # 1 Walls (B) Farm

Petroleum Inc. Company

Garvie Contractor

330 Ft. from N. Line

Ft. from S. Line

330 Ft. from E. Line

Ft. from W. Line

NE NE SE



1952 Elev. 1910 REPORT

9/17 Spud 9-11-52  
8" @ 280 Anhy 756'  
Drlg. 2910'

9/24 Spud 9-11-52 D&A TD 3857  
8" @ 280 Anhy 756 Heeb. 3281  
B<sub>r</sub> lime 3414 Lans. 3434  
DST 3438-65 opn 1/2 hr. Rec. 10' mud  
220# DST 3539-62 opn 1/2 hr.  
Rec. 10' mud 230# Simp 3794  
Arb. 3850 DST 3851-57  
opn 1 hr. Rec. 45' sw 1200#  
TD 3857 D&A

**ABANDONED**



