


KANSAS

Stafford

Section 28 Township 22 Range 14WWell No. #1 SymsCompany ~~G & G et al.~~ Huber et al
Wildcat

NORTH

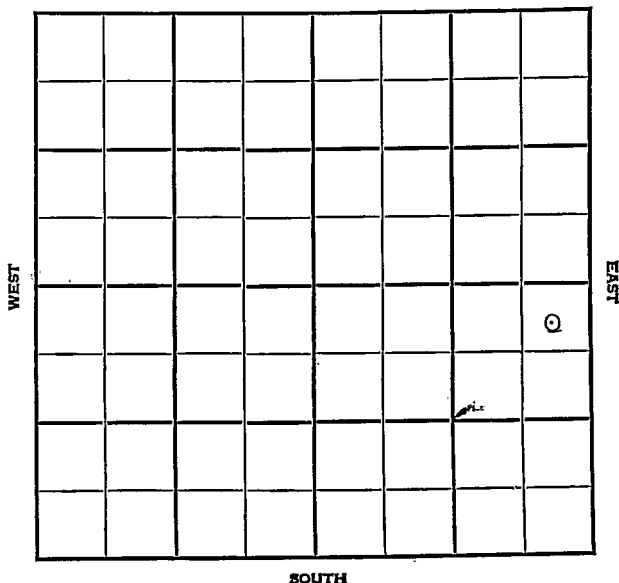

KANSAS

Stafford


✓

Sec. 28 Twp. 22 R. 14WWell No. #1 Syms Farm~~C. & G. et al~~ Huber et al Company

Wildcat

330 Ft. from N. Line Ft. from S. Line330 Ft. from E. Line Ft. from W. Line

NE SE

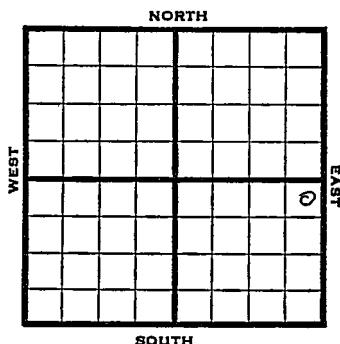

1948

Elev. 1959' REPORT

4/7	Location
4/14	8" @ 260' Drlg. 2260'
4/21	Heebner 3369' Lansing 3509' Drlg. 3688'
4/28	BKC 3742' Viola 3831' Simpson 3885' Arbuckle 3938-44' TD 3944' 5" @ 3939' RUST
5/5	"
5/12	Drlg. 3945' 1000' W 1 hr.
5/19	18 shots 3675-88 Water
5/26	Squeeze
6/1	24 shots 3696-3704' - 3000 acid Flow 145 bbls. oil in 11 hrs
6/9	"
6/16	Pump 190 bbls oil in 8 hrs 10% wtr.

OVER

1948

6/23 Pump 216 bbls oil / 15 W in 24 hrs.

6/30 Lans. 3509'

5" @ 3938'

Arbuckle 3938'

Perf Lans.

3000 acid

P&F 480 oil & 8% W Pot.

Gr. 30°

TD 3945'

COMPLETED

Map No. _____ Sec. 28 Twp. 22 R. 14W

Well No. 1 Syms _____

C & G et al. _____ Company

FIRST REPORT _____ Contractor

NE SE


SECTION PLAT

330 Ft. from N. Line

_____ Ft. from S. Line

330 Ft. from E. Line

_____ Ft. from W. Line

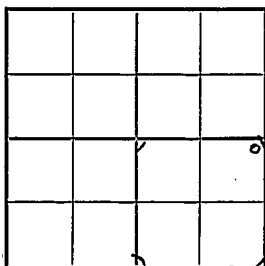

Stafford County

Location X

Rig up _____

Drilling and Remarks:

RECORD

Cased _____ in., _____ ft.

Sand _____

Gas _____

Oil _____

Total Depth _____

PRODUCTION

1st 24 hrs. Nat. _____

1st 24 hrs. after shot _____

Gas _____ Cu. Ft.

Dry Hole _____

Abandoned _____

Date

APR 7 1948 19 _____ S. J. LEWIS Scout

Map No. 82 Sec. 28 Twp. 22 R. 14W

Well No. 1 Symms

Huber etal. Company

CORRECTION

Contractor

NE SE

SECTION PLAT

330 Ft. from N. Line

 Ft. from S. Line

330 Ft. from E. Line

 Ft. from W. Line

			o

Stafford County

Location

Rig up

Drilling and Remarks:

Reported

C & G etal.

RECORD

Cased in.; ft.

Sand

Gas

Oil

Total Depth

PRODUCTION

1st 24 hrs. Nat.

1st 24 hrs. after shot

Gas Cu. Ft.

Dry Hole

Abandoned

Date

APR 14 1948

19

S. J. LEWIS

Scout

Map No. 82 Sec. 28 Twp. 22 R. 14W

Well No. 1 Symms

Huber et al. Company

COMPLETE

Contractor

NE SE

E 11 1938
SECTION PLAT

330 Ft. from N. Line

 Ft. from S. Line

330 Ft. from E. Line

 Ft. from W. Line

			o

Stafford County

Location

Rig up

Drilling and Remarks:

Land 300?
5' @ 393?
Ar + 3938
Prof 4 am.
3000 acs
P. & F. 480 oil + 8%
NP&D 2028

RECORD.

Cased in.; ft.

Sand

Gas

Oil ✓

Total Depth 3945

PRODUCTION

1st 24 hrs. Nat.

1st 24 hrs. after shot

Gas Cu. Ft.

Dry Hole

Abandoned

Date

JUN 30 1948

19

S. J. LEWIS

Scout