

Section 28 Township 22 Range 14W

Well No. 1 Tucker

Company Aikins & Robinson

NORTH

			0				

WEST

EAST

SOUTH

Sec. 28 Twp. R.

#1 Tucker

Well No. Farm

Aikins & Robinson

Company

B & B Drlg.

Wildcat

Contractor

330

Ft. from N. Line


Ft. from S. Line

330

Ft. from E. Line

Ft. from W. Line

NE NE NW

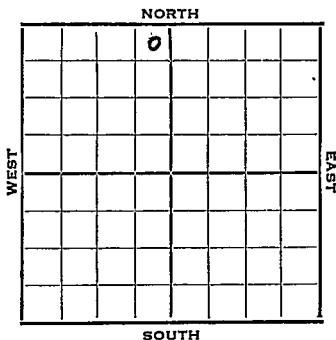

1952

Elev. 1950' REPORT

12/10 Spud 12-4-52  
8" @ 250  
Anhy 860  
Drlg. 2470'

12/11 Ø2470

12/18 Heeb 3378 Br 1 3507 Lans 3518 DST  
3631-45 1/4 Hr. 30'M 610# Cong 3815  
V 3849 Ø3902

12/23 Spud 12-4-52 D & A TD 3974'  
8" @ 250 Anhy 860' Heeb 3378'  
Br. lime 3507' Lans. 3518'  
DST 3631-3645 open 3/4 hr. rec 30' mud  
610# Cong. 3815' Viola 3849'  
Simp. 3892'  
DST 3919-50 open 1/2 hr. rec 15' mud 0#  
Arb. 3964' TD 3974'  
D & A

**ABANDONED**

County **Stafford** State **Kansas**

Sec. **28** (Blk.) **22** (Sur. Rge.) **14W** Map No.

Operator **Aikins & Robinson**

Well No. **1** Farm **Tucker**

Elev. Location **NE NE NW**

		0			

**330** Ft. From **N** Line **NW**

**330** Ft. From **E** Line **Quarter**

Ist. Report **DEC 10 1952**

Completion

Remarks

**B & B Drlg. - Contr.**

Spudding Date **12-4-52**

Drlg. Data **Wildcat**

**8" @ 250 Any 860 drlg. 2470**

J. G. McGEHEE

