


Section 28 Township 22 Range 14W

Well No. 1 Synns

Company France-Central & Carl Todd

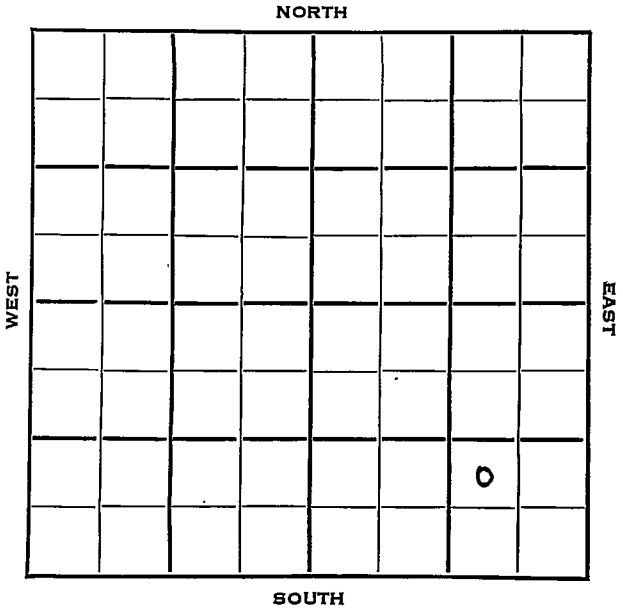

Stafford KANSAS

SEC.	TWP.	R.
28	22	14W ✓


WELL NO. 1 Synns FARM

COMPANY Franco-Central & Carl Todd

CONTRACTOR Todd Drlg.

Nellie Pool

_____ Ft. from N. Line
 990 _____ Ft. from S. Line
 990 _____ Ft. from E. Line
 _____ Ft. from W. Line

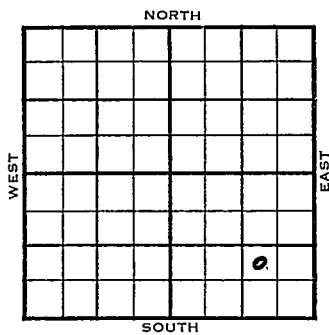

NW SE SE

	ELEVATION	REPORT
1954	1947'	

3/3 Spud 3-1-54
 8" @ 255', WOC

3/10 Heeb 3366', Br li 3494', Lans 3505'
 DST 3691-95'

3/17 Spud 3-1-54
 D & A
 TD 3958'
 8" @ 255'
 Heeb 3366', Br. Lime 3494 Lans 3505'
 DST 3685'-3700' opn 1 hr, rec 2000' gas
 55' hocom 50' socm & wtr.
 600 # B KC 3737', Cong 3809'
 Viola 3822' Simp 3877', Arb 3941'
 TD 3958'
 D & A

ABANDONED

