


Pawnee

Section 28 Township 22 Range 15W

Well No. #2 Smith "A"

Company Natural Gas & Oil CSO

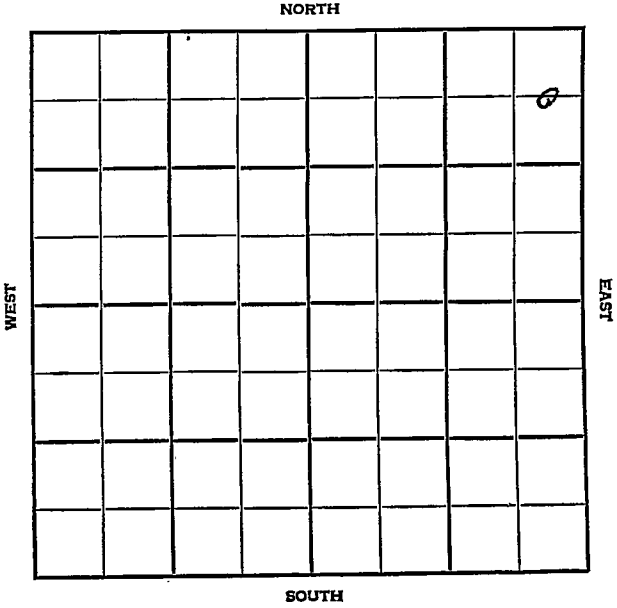

Pawnee

KANSAS

SEC.	TWP.	R.
28	22S	15W

WELL NO. #2 Smith A FARM

COMPANY Nat. Gas & Oil & Cities Service

CONTRACTOR


Dunes

_____ Ft. from N. Line

_____ Ft. from S. Line

_____ Ft. from E. Line

_____ Ft. from W. Line

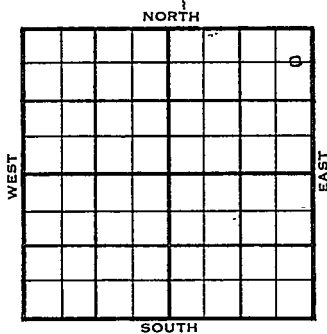

C E/2 NE NE

1/2 mile Surray

1955	ELEVATION	REPORT
------	-----------	--------

5/26

1995[†]

Lsg 3542; BKC 3780; Conga 3846;
 Viola 3876; Simp Sh 3951; Simp Sd
 3960; Simp dol 3966; Arb 4001;
 TD 4015; 8" 215; DST 3937-75 open
 1 hr rec 15' mud, 0# BHP
 DST 3982-84 open 1 hr rec 230' gas
 40' ho and gcm, BHP 590#
 DST 3982-89 open 1 hr, rec 30'
 sogcm, log;
 DST 3969-79 open 1hr rec 135'
 gas, 45' so and gcm, 1180# BHP;
 D&A

FIRST REPORT

ABANDONED

FIRST REPORT ABANDONED

FORM 513 REV. SUNRAY

County Pawnee Elev. 1995
 Sec. 28 Twp. 22 Rge. 15W
 Company Natural Gas & Oil & CSO
 Farm Name Smith "A" No. 2

TOPS	DEPTH	DATUM
Cim. Anhydrite	950	
Ft. Riley		
Howard		
Topeka		
Heebner Sh.		
Toronto Ls.		
Brown Lime		
Lansing	3542	1547
Kans. City		
B. K. C.	3780	1785
Congl.	3846	1851
Miss.		
Kinderhook		
Misener		
Hunton		
Sylv. Maquo		
Viola	3876	1881
Simpson <i>sh.</i>	3951	1956
Smp. <i>sd</i>	3960	1965
<i>Graham Simpson del.</i>	3966	1971
Arbuckle	4001	2006
Basal Sand		
Pre. Cam.		
T. D.	4015	

Loc. in Section
C E $\frac{1}{2}$ NE NE

Drig. Contr.
 Pool Dunes

			0

Date Comm.
 Date Comp. MAY 25 '55

Spud 5-11-55 8" @ 215 w/ 200

DST 3937-75 open 1 hr. Rec. 15' mud

0# DST 3982-84 open 1 hr. Rec.

230' gas 40' ho & gcm 590/30"

DST 3982-89 open 1 hr. Rec. 30' sogcm

DST 3969-79 open 1 hr. Rec. 135' gas

45' so & gcm 7180/30"

D & A