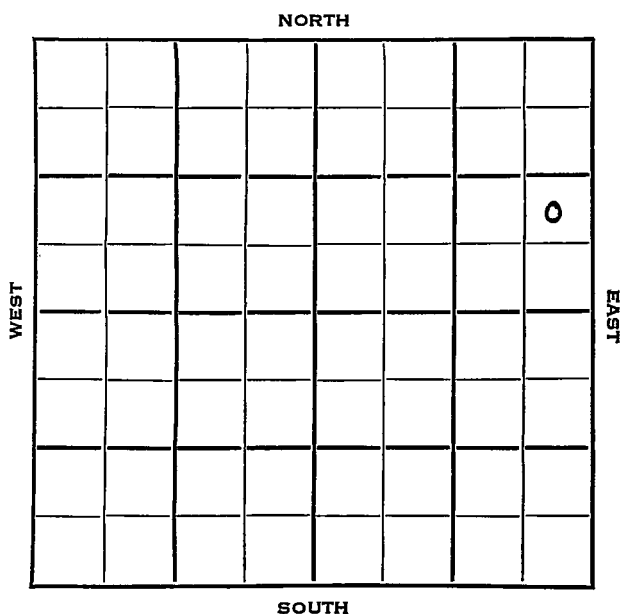


Section 28 Township 22 Range 15WWell No. 1 O. E. Smith "A"Company Natural Gas & Oil & CSO

Pawnee

KANSAS

SEC.	TWP.	R.
28	22	15W

WELL NO.

#1 O.E. Smith "A"

FARM

COMPANY

Natural Gas & Oil & CSO

CONTRACTOR

Natural G & O

Dunes Pool


NORTH

Ft. from N. Line

990 Ft. from S. Line

330 Ft. from E. Line

Ft. from W. Line

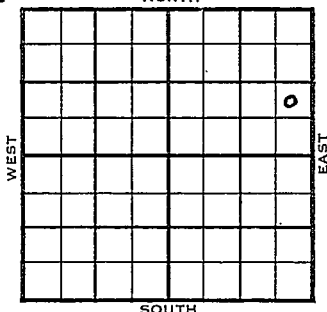

NE SE NE

1954	ELEVATION 1995'	REPORT
3/10	M I R	
3/17	10" @ 206' w/200 sks Anhy 950' Drlg 2805'	
3/24	Heeb 2415', Br. L. 3531', Lans 3541' DST 3543'-55' 1 hr, 15' M 100# B KC 3775', Cong 3846' V 3881', Simp 3936' DST 3956'-66' 1 hr, 120' gas, 65' Hly OCM, 1250# Arb 3980' DST 3981'-90' 1 hr, 240' gas, 3240' gco, 60' o & gcm, 1100# RTD 3990' 5" @ 3989'	
3/31	WOCT	
4/7	DD 3992'	
4/28	Spud 3-10-54 Oil Well TD 3992' 10" @ 206' Anhy 950', Heeb 3415', Br. Lime 3531', Lans 3541' DST 3543'-55' opn 1 hr, rec 15' Mud 100# B KC 3775', Cong 3846', Viola	

1954

Information brought forward.

4/28

3881', Simp 3936'

DST 3956'-66' opn 1 hr, rec 120' gas
65' hccm 1250# Arb 3980'

DST 3981'-90' opn 1 hr, rec 240' gas
3240' gco 60' o & gcm 1100#

TD 3990'

5" @ 3989'


DD3992'

FU 2500' oil S/ 20 boph 2 hr.

S/ 96 bo

Comp 240 bopd.

COMPLETED

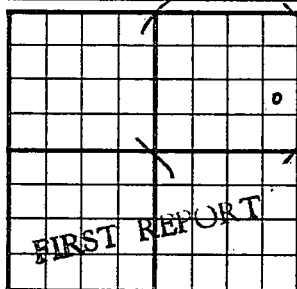County Pawnee State KansasSec. 28 (Blk.) 22 (Sur.) 15W Map No.Operator Natural Gas & Oil & GSOWell No. 1 Farm O. E. Smith "A"Elev. Location NE SE NE990 Ft. From S Line NE330 Ft. From E Line Quarter1st. Report MAR 10 1954


Completion

Remarks

Natural G & O - Contr.

Spudding Date

Drilg. Data Dunes PoolM I R

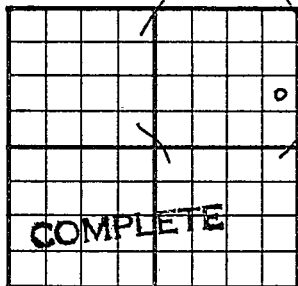County Pawnee State KansasSec. 28 (Blk.) 22 (Sur.) 15W Map No.Operator Natural Gas & Oil & CSOWell No. 1 Farm O. E. Smith "A"Elev. 1995 Location NE SE NE990 Ft. From S Line NE330 Ft. From E Line Quarter

1st. Report

Completion APR 28 1954Remarks Dunes PoolNatural G & O - Contr.Spudding Date 3-10-54Drig. Data Oil well TD 399210" @ 206 Anhy 950 Heeb. 3415Br. lime 3531 Lans. 3541 DST 3543-55open 1 hr. Rec. 15' mud 100# B KC 3775Cong. 3846 Viola 3881 Simp. 3936DST 3956-66 open 1 hr. Rec. 120' gas65' hocm 1250# Arb. 3980 DST 3981-90open 1 hr. Rec. 240' gas 3240' gco60' o. & gcm 1100# TD 3990 5" @ 3989DD 3992 FU 2500' oil S/ 20 boph 2 hr.S/ 96 bo Comp. 240 bopd

J. G. McGEHEE