


Section 28 Township 22 Range 10W

Well No. 1 Parrett

Company M. B. Armer

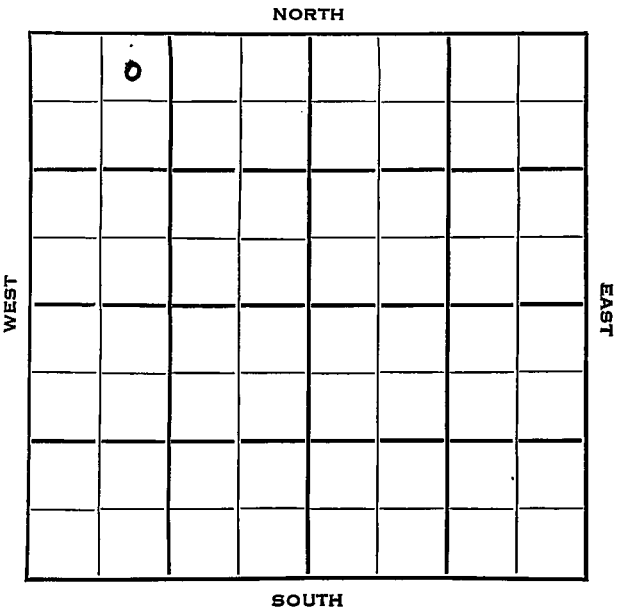

SEC.	TWP.	R.
28	22	10W ✓

WELL NO.

1 Parrett

FARM

COMPANY

M. B. Armer

CONTRACTOR

Armer


Wildcat

330 Ft. from N. Line

Ft. from S. Line

Ft. from E. Line

990 Ft. from W. Line

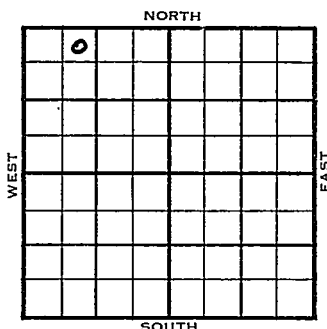

NE NW NW

Phillips - DHM - Atlantic-AC

	ELEVATION	REPORT
1954	1777'	

3/3 Spud 2-26-54
8" @ 210'
Anhy 430'
Drlg. 1590'

3/10 Heeb 3019'; Br li 3164', Lans 3190',
B KC 3481', Marm 3487', V 3562'
DST 3563-69', 1 hr., 3060' oil, 1220#
Simp 3601', arb. 3660'
RTD 3677'
5" @ 3661'

3/17 Log
32/3560-68
FU 3677' oil 1½ hrs., ran over top
pipe

3/24 F 32 BOPH 4 hrs.

4/28 Spud 2-26-54
Oil Well
TD 3677'
8" @ 210'

Top 2724', Anhy 430', Heeb ~~312~~ 3019'
Br. Lime 3164', Lans 3190', B KC 3482'
Marm 3487', Viola 3562'
DST 3563'-69' opn 1 hr, gas in 38 min
~~Rec 3600' oil~~

OVER

1954

Information brought forward.

4/28

Rec 3060' oil 1220#

Simp 3601' Arb 3660'

TD 3677'

5" @ 3661'

32/ 3560-68' FU 3677' oil $1\frac{1}{2}$ hr.

F/ 32 boph 4 hr.

Comp 485 bopd.

COMPLETED

County Reno State Kansas
 Sec. 28 (Blk. 22 (Sur. 10W Map No.
 (Twp.) (Rge.)
 Operator M. E. Armer
 Well No. 1 Farm Parrett
 Elev. Location NW NW NW

0							

FIRST REPORT

330 Ft. From N Line NW
990 Ft. From W Line Quarter
 Ist. Report MAR 3 1954
 Completion
 Remarks Phillips - DIM
Atlantic - AC
Armer - Contr.
 Spudding Date 2-26-54.

Drlg. Data Wildcat
8" @ 210 Anhy 430 drlg. 1590

County Reno State KansasSec. 28 (Blk.) 22 (Sur.) 10W Map No.Operator M. B. ArmerWell No. 1 Farm ParrettElev. 1777 Location NE NW NW

0						

330 Ft. From N Line NW990 Ft. From W Line Quarter

1st. Report

Completion APR 28 1954Remarks WildcatArmer - Contr.Spudding Date 2-26-54Drilg. Data Oil well TD 36778" @ 210 Anhy 430 Top. 2724Heeb. 3019 Br. lime 3164 Lans. 3190B KC 3481 Marm. 3487 Viola 3562DST 3563-69 open 1 hr. gas in 38 min.Rec. 3060' oil 1220# Simp. 3601Arb. 3660 TD 3677 5" @ 3661 32/ 3560-68 FU 3677' oil 1½ hr. F/ 32 boph 4 hr/Comp. 485 bopd

J. G. McGEHEE