


DX 78-1 Stafford

KANSAS

Section 28 Township 22 Range 11W

Well No. #1 Curtis

Company Anschutz

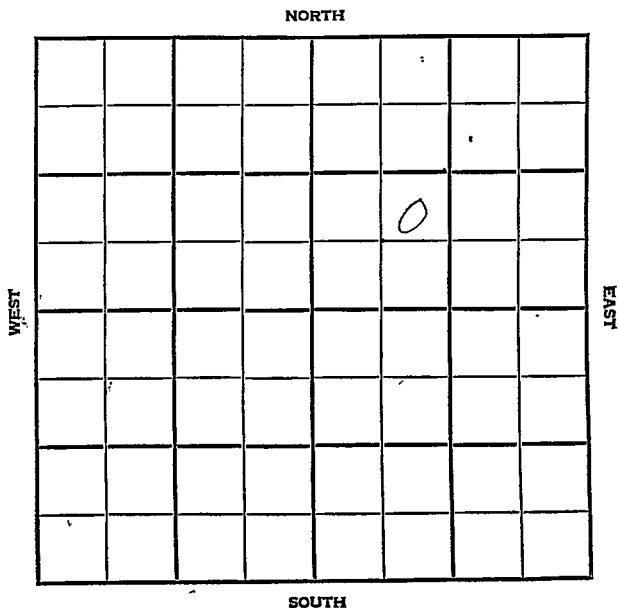

Stafford

KANSAS

SEC.	28	TWP.	22	R.	11W
------	----	------	----	----	-----

WELL NO.

#1 Curtis

FARM

COMPANY

Anschutz

CONTRACTOR

Co. Tools

WILDCAT


Ft. from N. Line

Ft. from S. Line

Ft. from E. Line

Ft. from W. Line

NE SW NE

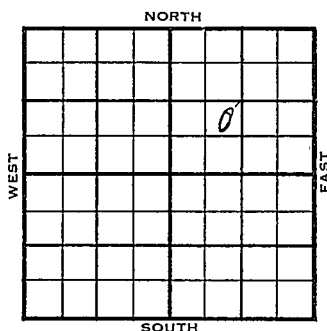

1956

ELEVATION

1812'

REPORT

3-21

Comm. 3-16-56

8" @ 246/200

Drlg. 1965

5-16

DST 3289-95 op 1 hr. rec. 30' mud, Off.

DST 3624-30 op $\frac{1}{2}$ hr. rec. 14' mud, 0/15"

DST 3634-38 op 1 hr. rec. 35' o&gcm,

40' hgem, 20' free oil, 1200#.

5 $\frac{1}{2}$ " @ 3636

CO to 3638

FU 300' oil,

S/ 1 boph, 3 hrs., 250 A

S/ 7.13 boph, 6 hrs.

P/ 56 bo, 16 hrs.

P/ 76 bo, 24 hrs.

P/ 54 bo, 24 hrs.

Comp. 76.56 bopd, 8% wtr.

TD 3638'

H. 3083', BL. 3223', L. 3248',

C. 3542', S. 3574', A. 3635',

COMPLETED

County **Stafford**

Elev.

Sec. **28**Twp. **22**Rge. **11W**Company **Anschutz**Farm Name **Curtis**No. **1**

TOPS

DEPTH

LOG

DATUM

Loc. in Sec.

Anh.

Tp.

H.

Tr.

Dg.

Bl.

L.

K.C.

B.K.C.

Ce.

C.

M.

M.

K.

Mz.

Mq.

V.

S.

S.

A.

R.

P.E.

G.

T.D.

NE SW NE

Geol.

Contr.

Co. tools

Pool

Wildcat

MAR 21 '56
0

FIRST REPORT

Date Comm. **3-16-56**

8" @ 246/200 drlg. 1965

13

County Stafford Elev. 1812
 Sec. 28 Twp. 22 Rge. 11W
 Company Anschutz Drlg.
 Farm Name Curtis No. 1

TOPS	DEPTH	LOG	DATUM	Loc. in Sec.
Anh.				NE SW NE
Tr.				
H.	3083			
Tr.				
Dg.				
Bl.	3223			
L.	3248		1436	Geol.
K.C.				Contr.
B.K.C.				Co. tools
Ce.				Pool
C.	3541		1729	
M.				
M.				
K.				
Mz.				
Ma.				
V.				
S.	3574		1762	
S.				
A.	3635		1823	
R.				
PE.				
G.				
T.D.	3638			

Date Comm. 3-16-56 MAY 16 1956

8" @ 246/200 DST 3289-95 open 1 hr.

rec. 30' mud 0# DST 3624-30

open $\frac{1}{2}$ hr. rec. 14' mud 0/15"

DST 3634-38 open 1 hr. rec. 35' o &

gcm 40' hgm 20' free oil 1200#

5 $\frac{1}{2}$ " @ 3636 CO to 3638 FU 300' oil

S/ 1 boph 3 hr. 250 A S/ 7.13 boph

6 hr. P/ 56 bo 16 hr. P/ 76 bo 24 hr.

OVER

MAY 28 1956

R. G.

P/54 bo 24 hr. Comp. 76.56 bopd 8% wtr