


Section 28 Township 22 Range 11W

Well No. #1 Curtis

Company G-M-R Oil et al

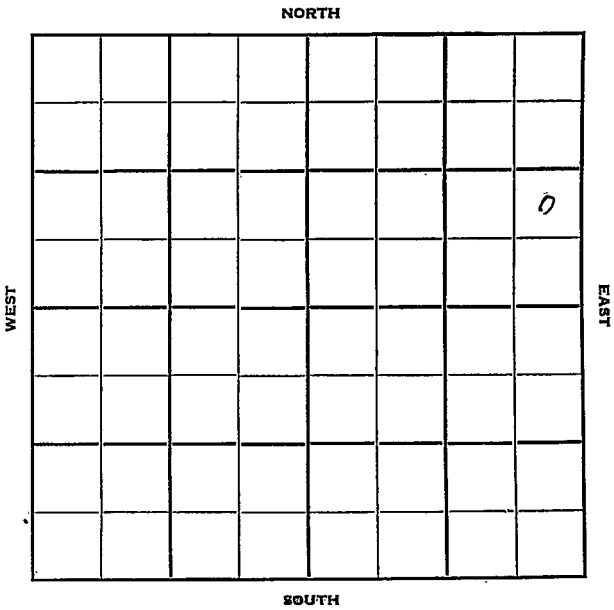

Sec. 28 Twp. 22 R. 11 W

Well No. #1 Curtis Farm

G-M-R Oil et al Company

Braden Drlg. Contractor

Wildcat


Ft. from N. Line

990 Ft. from S. Line

330 Ft. from E. Line

Ft. from W. Line

NE SE NE

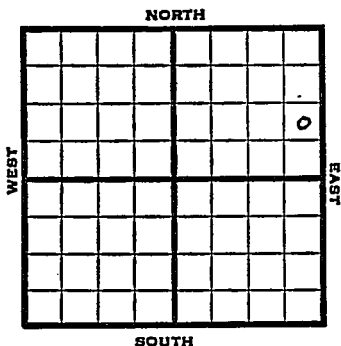

1951

Elev. 1813'

REPORT

2/7

Location

2/28

D&A TD 3702

8" @ 230

Lans. 3272 Cong. 3570

Viola 3585 Simp 3612

Arb. 3672

TD 3702' D&A

**ABANDONED**



County Stafford State Kansas

Sec. 28 (Blk. 22) (Sur. 11W) (Rge.) Map No.

Operator G-M-R Oil etal.

Well No. 1 Farm Curtis

Elev. 1813 Location NE SE NE

					0
<b>ABANDONED</b>					

990 Ft. From S Line NE

330 Ft. From E Line Quarter

Ist. Report

Completion FEB 28 1951

Remarks Wildcat

Braden Drlg. - Contr.

Spudding Date

Drlg. Data D & A TD 3702

8" @ 230 Lans. 3272 Cong. 3570

Viola 3585 Simp. 3612 Arb. 3672

TD 3702 D & A

2 17 56