

Stafford


KANSAS
LWF

SECTION 28 TOWNSHIP 22 RANGE _____

WELL NO. #1 Curtis "A"

COMPANY Anschutz Drlg.

NORTH

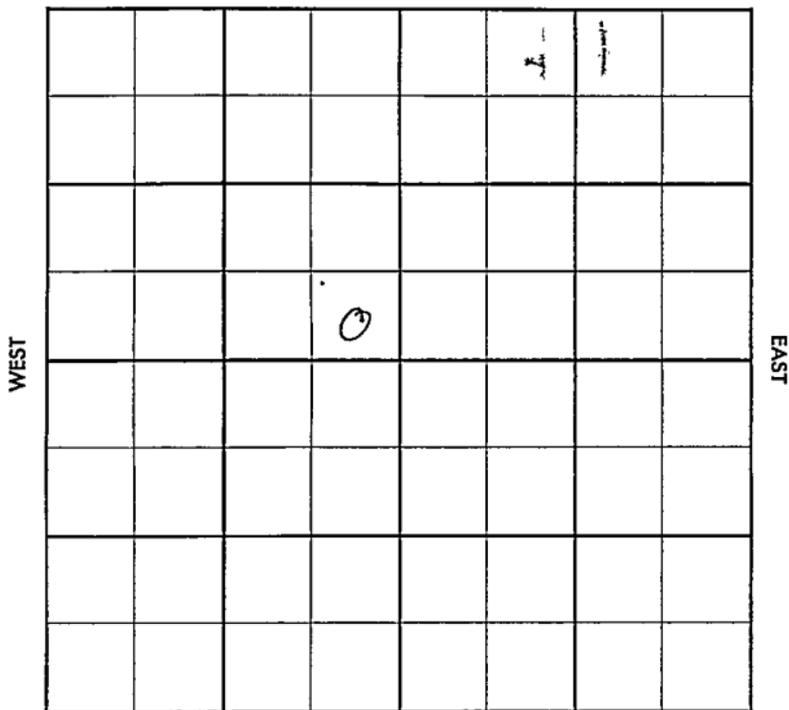


SOUTH

SEC.	TWP.	R.
28	22	11W

WELL NO. ~~#####~~ #1 Curtis "A" FARM

COMPANY Anschutz Drlg.

CONTRACTOR Anschutz

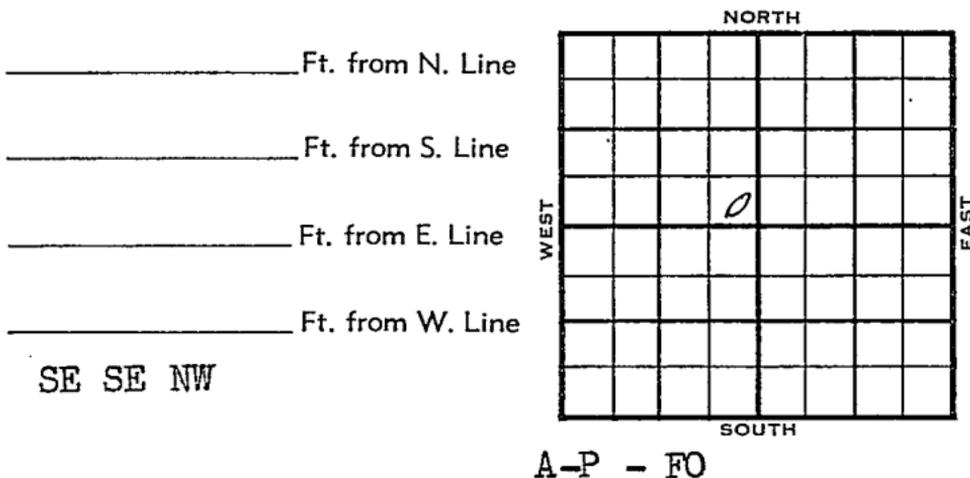

1956 ELEVATION 1811' REPORT

4-11 Comm. 4-4-56
8" @ 346 w/175
Drlg. 2995

5-16 DST 3637-40 op 90 min. rec. 450' gas +
90' HO&GCM, BHP 1100#
5 1/2" @ 3637 1/2' w/100
CO 3640', 110 gal acid,
FU 350' oil, no/wtr.
S/ 89 BOPH, no/wtr. 2 hrs.
S/ 10.72 Bo in 5 hrs.,
FU 1100' oil, no/wtr., 12 hrs.
S/ 1.75 BOPH
S/ 60.93 BO, no wtr., 7 hrs.
TD 3640'
H. 3082', BL. 3220', L. 3246',
C. 3539', S. 3578', A. 3637',
POP
P/ 47 BO, no/wtr., 20 hrs.
P/ 40 BOPD, 10% wtr.
Grav. 39°

COMPLETED

County Stafford Elev. _____
 Sec. 28 Twp. 22 Rge. 11W
 Company Anschutz Drlg.
 FarmName Guthrie #411 No. 1

TOPS	DEPTH	LOG	DATUM	Loc. in Sec.
Anh.				SE SE NW
TP.				
H.				
Tr.				
Dg.				
Bl.				
L.				Geol. _____
K.C.				Contr. _____
B.K.C.				<u>Anschutz</u>
Ce.				Pool _____
C.				
M.				
M.				
K.				
Mz.				
Mo.				
V.				
S.				
S.				
A.				
R.				
PC.				
G.				
TD.				

APR 1 1956
 FIRST REPORT

Date Comm. 1-1-56 A-P - FO
8" @ 316/175 drlg. 2995

[Handwritten scribbles and signatures]

APR 1 1956
 R.C.

Co.
 Lse.
 No.
 Sec.
 T.
 R.

County Stafford Elev. 1811
 Sec. 28 Twp. 22 Rge. 11W
 Company Anschutz Dtlg.
 Farm Name Curtis "A" No. 1

TOPS	DEPTH	LOG	DATUM	Loc. in Sec.
Anhr				SE SE NW
TP				
H.	3082			
Tr.				
Dg.				
Bl.	3220			
L.	3246			
K.C.				Geol.
BXC				Contr.
Ce.				Anschutz
C.	3539			Pool
M.				
M.				
K.				
Mz.				
Me				
V.				
S.	3578			
S.				
A.	3637			
R.				
PE				
G.				
TD	3640			

MAY 16 1956
 COMPLETE

Date Comm. 11-1-56

8" G 316/175 Est. 2995 APR 18 '56

DST 3637-40 90" net 450' gas

4 90' HO5 GCM BHP 1100 5 1/2

@ 3637 1/2 / 1100 APR 25 '56 CO 3640 110

gal acid FU 350' oil no/w

\$.89 Boph no/w 2 hrs 1/4

\$ 10.72 BO in 5 hrs FU 1100'

oil no/w 12 hrs \$ 1.75 Boph

3/4 \$ 60.93 BO no/w 7 hrs T&R

MAY 1 '56

MAY 2 '56

Pop P. 47 Bo

no lw 20 hrs wo Pot. MAY 15 '56 X st.

fst P. 40 Bopd 10% wts.

Arb O.H 3637½ - 3640 RTD

gran 39°