


Section 28 Township 22 Range 11W

Well No. #1 Lofland (*Lofland*)

Company Keyes Drlg.

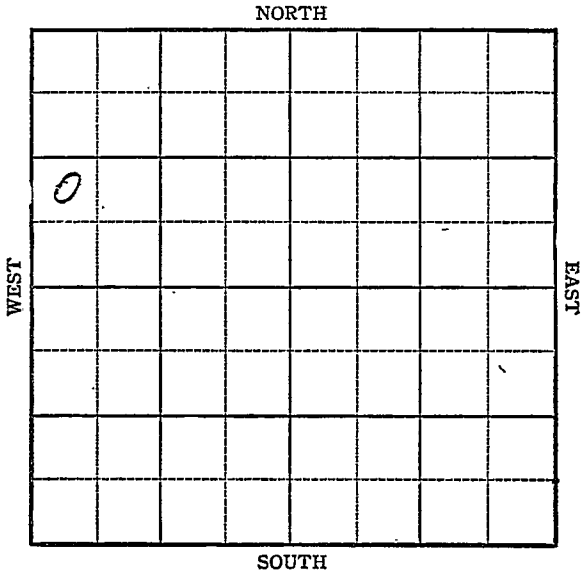

KANSAS

Stafford County

Sec. 28 Twp. 22 R. 11W

Well No. #1 Lofland Farm

Keyes Drlg. Company

Wildcat


_____ Ft. from N. Line

990 Ft. from S. Line

_____ Ft. from E. Line

330 Ft. from W. Line

NW SW NW

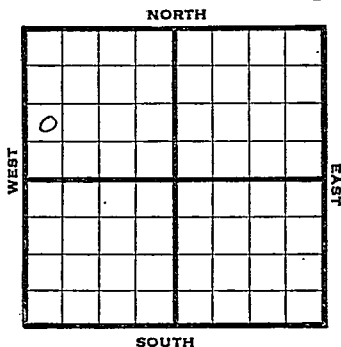

1944

R E P O R T

12/13 Location
12/21 8" @ 226' WOC
12/29 Drlg. 2240'

1945

1/10 Cong 3556
Simp 3592
Arb 3629
TD 3631

ABANDONED

Pool Name WildcatMap No. 46 Sec. 28 Twp. 22 R. 11WWell No. 1 Lofland

Keyes Drlg.

Company

FIRST REPORT

Contractor

NW SW NW

SECTION PLAT

o			

_____ Ft. from N. Line

990 Ft. from S. Line

_____ Ft. from E. Line

330 Ft. from W. LineStaffordLocation X

Rig up _____

Drilling and Remarks:

RECORD

Cased _____ in., _____ ft.

Sand _____

Gas _____

Oil _____

Total Depth _____

PRODUCTION

1st 24 hrs. Nat. _____

1st 24 hrs. after shot _____

Gas _____ Cu. Ft.

Dry Hole _____

Abandoned _____

Date

DEC 1 3 1944

19

S. J. LEWIS

Scout

