


DX 78-1 Stafford

KANSAS

Section 28 Township 22 Range 11W

Well No. #1 Lofland

Company Anschutz

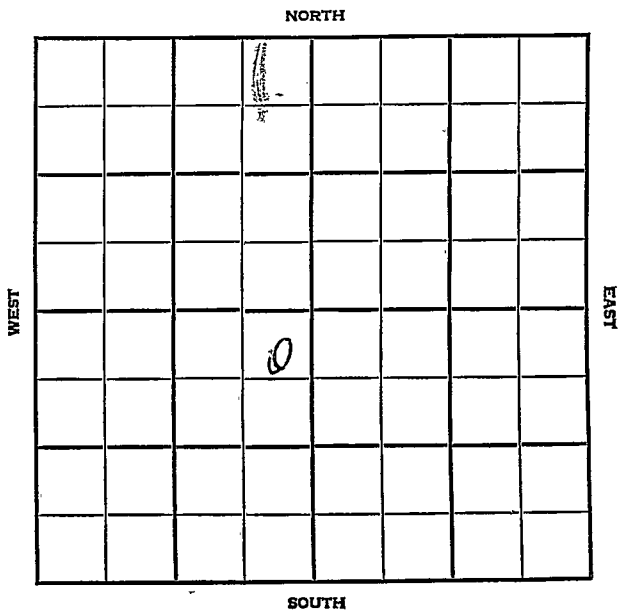

1811 RB

County Stafford Elev. 1808 DF
 Sec. 28 A 22 Rge. 11W
 Company Anschutz
 Farm Name Dofland No. 1

TOPS	DEPTH	LOG	DATUM
Anh.			
TP.			
H.	3079		
Tr.			
Dg.			
Bl.	3218		
L.	3246		
K.C.			
B.K.C.			
Ce.			
C.	3541		
M.			
M.			
K.			
Mz.			
Mo.			
V.			
S.			
S.			
A.			
R.			
PE.			
G.			
TD.			

Loc. in Sec. NE NE SW
 Geol. _____
 Contr. _____
 Co. tools _____
 Pool _____
 White Cloud

FIRST REPORT
 JUN 6 36

Date Comm. 5-28-56
8" @ 253/175 drlg. 3552

JUN 1 1956

R. G.

Co.
 Lse.
 No.
 Sec.
 T.
 R.

County Stafford Elev. 1808 DF

Sec. 28 Twp. 22 Rgn. 11W

Company Anschutz

Farm Name Lofland No. 1

TOPS	DEPTH	LOG	DATUM	Loc. in Sec.
Anh				NE NE SW
Ip				
H.	3079			
Tr.				
Dg				
Bl.	3216			
L.	3216			Geol.
K.C.				Contr.
B.K.C.	3477			
Cc.				Co. tools
C.	3511			
M.				Pool
M.				White Cloud
K.				
Nr.				
Mg				
V.	No			COMPLETE
S.	3578			
S.				
A.	3635			
R.				
PE.				
G.				
TR	3635			

Date Comm. 5-28-56 JUL 3 1956

8" @ 253/175 drlg. 3552 JUN 13 '56

DST 3630-36/dhw/ Cas. 16 min -

R. 3300' oil IF 340-980 BHP

980, 5" 3633 1/2 - MCT. JUN 22 '56

cracked shoe. FU 200' oil nel

wt 12 hrs ca 3635 FU

1500' oil & 8 1/4 Bopk noku

shoe 2000 OB T&R JUN 27 '56

P. 76 B0 nolw 18 hrs JUL 3 '56

28-22-11W NE NE SW

Ph P. 120 B0 no/wtr
24 hrs.