


Section 28 Township 22 Range 11W

Well No. #2 Pagley

Company Petroleum Inc.

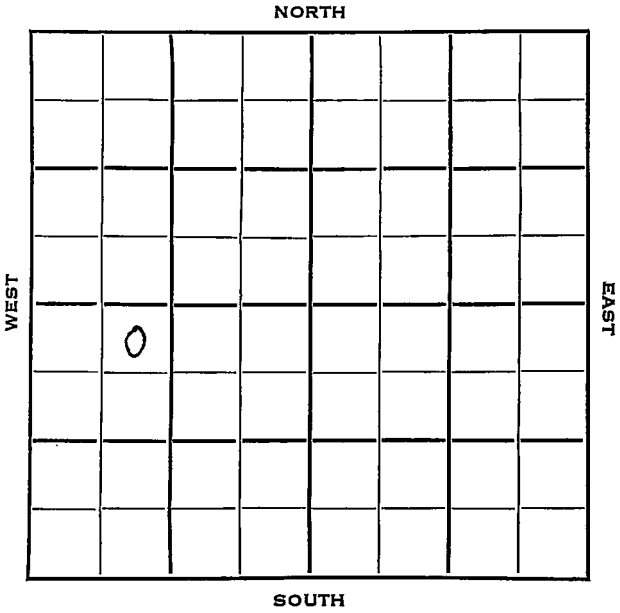

Stafford

KANSAS


SEC. 28	TWP. 22	R. 11W
-------------------	-------------------	------------------

WELL NO. _____
 #2 **Pagley** FARM

COMPANY _____
Petroleum Inc.

CONTRACTOR _____
Petroleum Inc.

330 _____ Ft. from N. Line
 _____ Ft. from S. Line
 _____ Ft. from E. Line
990 _____ Ft. from W. Line

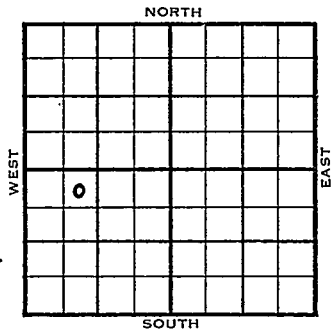

NE NW SW

	ELEVATION	REPORT
1953	1811'	

10/7
 Spud 9-30-53
 8" @ 210'
 Anhy 545'
 Drlg 2965'

10/14
 Spud 9-30-53 D & A TD 3690
 8" @ 210 Anhy 545 Heeb 3088
 Tor 3108 Br lime 3228 Lans 3253
 Cong 3548 Viola 3555 Simp 3592
 Arb. 3650 TD 3690 D & A

ABANDONED

