


SECTION 28 TOWNSHIP 22 RANGE 31W

WELL NO. #1 Meairs

COMPANY A.D. McKelvy

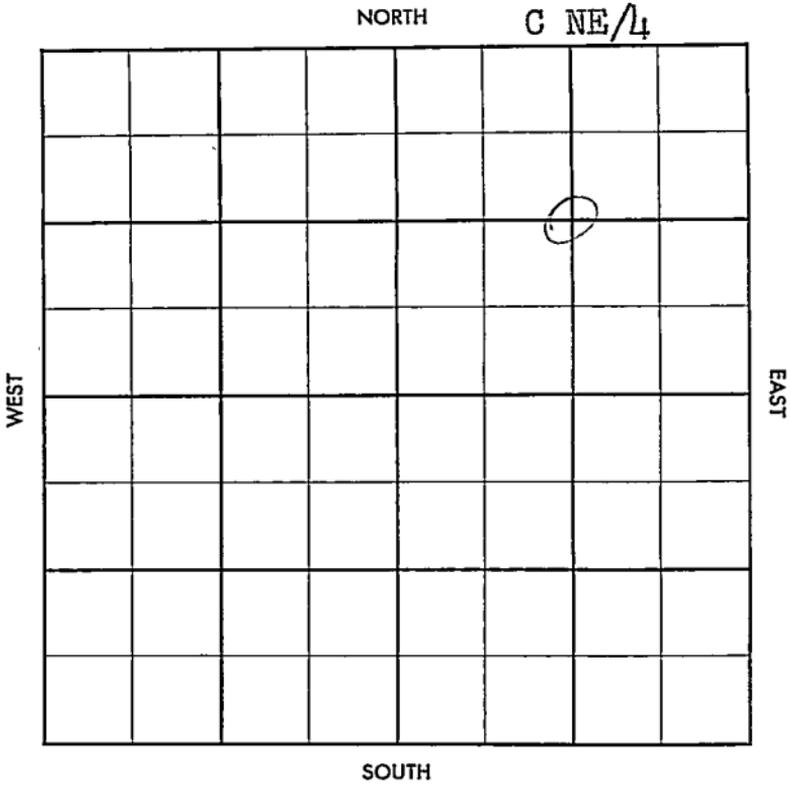

County Finney Elev. _____
 Sec. 28 Twp. 22 Rge. 31W
 Company A. D. McKelvy
 Farm Name Meairs No. 1

TOPS	DEPTH	LOG	DATUM	Loc. in Sec.
Anh.				C NE/4
Tr.				
H.				
Tr.				
Dg.				
Bl.				
L.				Geol. _____
K.C.				Contr. <u>Graham-</u>
B.K.C.				<u>Michaelis TL</u>
Ce.				
C.				
M.				Pool
M.				<u>Hugoton</u>
K.				
Mz.				
Ma.				
V.				
S.				
S.				
A.				
R.				
Pe.				
G.				
T.D.				

APR 17 57

FIRST REPORT

Date Comm. 4-15-57
 8" @ 359/200, Drlg. 1400

35

Co.
Lsg.
No. 1
Sec.
T.
R.


County Finney Elev. 2896 DF
 Sec. 28 Twp. 22 Rge. 31W
 Company A. D. McKelvy
 FarmName Meairs No. 1

TOPS	DEPTH	LOG	DATUM
Anh. <u>Hob1</u>		<u>2620</u>	
Tp. <u>Harr</u>		<u>2659</u>	
H. <u>WPK1</u>		<u>2682</u>	
Tr. <u>WPK1</u>		<u>2709</u>	
Dg. <u>Wpd</u>		<u>2746</u>	
Bl.			
L.			
K.C.			
B.K.C.			
Ce.			
C.			
M.			
M.			
K.			
Mz.			
Mo.			
V.			
S.			
S.			
A.			
R.			
PE.			
G.			
TD.	<u>2749</u>		

Loc. in Sec. C NE/4

Geol. _____
 Contr. Graham-
Michaelis Tl

Pool Hugoton

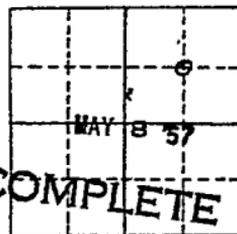

Date Comm. 4-15-57

8" @ 359/200, Drlg. 1400 APR 24 '57

5 1/2 2748/300 MAY 1 '57 No dope RT 5 1/2
Co 2748 4/2731-32 Sqd. Co 2730
48' 2684-96 36' 2713-22 N.S.
FRAC 6 X 6 72-20 ga S. 600
MCFGPD

Co.

Log.

No.

Sec.

T.

R.