

Finney

KANSAS

Section 28 Township 22 Range 33WWell No. #2 DanneCompany ~~W C R~~ Hartman

NORTH							
WEST							
SOUTH							
EAST							

Sec. 28 Twp. 22 R. 33 W

Well No. # 2 Damme Farm _____
W.L. Hartman
~~N C R A~~
 _____ Company _____

H & H Drlg.

S. Dammie Pool

_Contractor

_Ft. from N. Line

330


_Ft. from S. Line

330

Ft. from E. Line

Ft. from W. Line

SE SE SW

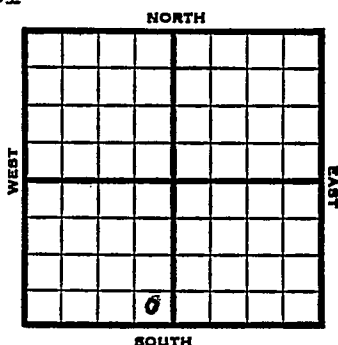

SOUTH

1953	Elev. 2887' REPORT
3/25	Spud 3-20-53 8" @ 375 Drlg. 1975'
4/2	NR
4/9	Heeb 3799, Lans 3837, Cherokee 4471 Drlg. 4544'
4/16	Miss 4697 DST 4778-97 2 hr. 30' gas 60' Hly ocm 1005# DST 4801-16 2 hrs. 45' M 1020# RTD 4895 Schl 5" @ 4895'
4/23	"
4/30	N.R.
5/7	Marm 4338
5/21	NR
5/28	NR
6/3	NR

OVER

1953
6/10

Spud 3-20-53 Oil well TD 4895
8" @375 Heeb 3799 Lans 3837
Cherokee 4471 Miss 4697
DST 4778-97 open 2 hr rec 30' gas,
60' HOCM 1005#
DST 4801-16 open 2 hr rec 45' mud
1020# TD 4895 5" @ 4895
Marm. 4338 32/4780-89 500 A
Comp. 135 BOPD

COMPLETED

Kansas

Map No. _____ Sec. 28 Twp. 22 R. 33WWell No. 2 Damme_____
W. L. Hartman Company

CORRECTION

Contractor

SE SE SW

SECTION PLAT

Ft. from N. Line330
Ft. from S. Line330
Ft. from E. Line_____
Ft. from W. Line

Finney County

Location _____

Rig up _____

Drilling and Remarks:

Reported
NCRA

RECORD

Cased _____ in., _____ ft.

Sand _____

Gas _____

Oil _____

Total Depth _____

PRODUCTION

1st 24 hrs. Nat. _____

1st 24 hrs. after shot _____

Gas _____ Cu. Ft.

Dry Hole _____

Abandoned _____


Date

APR 15 1952 19

J. G. McGEHEE

Scout

County Finney State Kansas
 Sec. 28 (Blk. 22 (Sur. 33W Map No.
 (Twp.) (Rge.)
 Operator Hartman
 Well No. 2 Farm Damme
 Elev. 2887 Location SE SESW

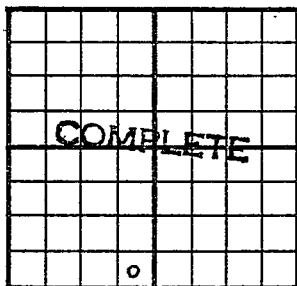

330 Ft. From S Line SW
330 Ft. From E Line Quarter
 1st. Report
 Completion JUN 10 1953
 Remarks S. Damme Pool
H & H Drlg. - Contr.
 Spudding Date 3-20-53

Drlg. Data Oil well TD 4895
8" @ 375 Heeb. 3799 Lans. 3837
Cherokee 4471 Miss. 4697 DST 4778-97
open 2 hr. Rec. 30' gas 60' hoom
1005# DST 4801-16 open 2 hr.
Rec. 45' mud 1020# TD 4895 5" @ 4895
Marm. 4338 32/ 4780-89 500 A
Comp. 135 bopd

J. G. McGEHEE