

Finney

KANSAS

28

22

33W

SECTION _____ TOWNSHIP _____ RANGE _____


WELL NO. #3 Damme

COMPANY W.L. Hartman

NORTH

WEST

EAST

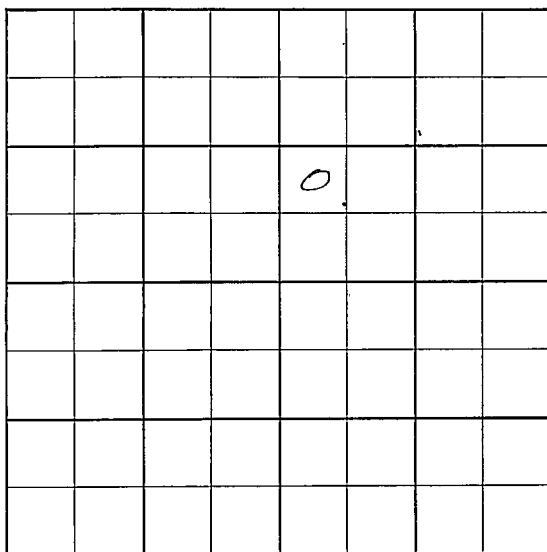

SOUTH

Date Comm. _____ Sec. _____
MIET

County Finney Elev. 2890
 Sec. 28 Twp. 22S Rge. 33W
 Company W. L. Hartman
 Farm Name Damie No. 3

TOPS	DEPTH	LOG	DATUM	Loc. in Sec.
Ank.				SW NE
TP.				
H.	3795			
Tr.				
Dg.				
BL.				
L.	3840			Geol.
K.C.				Contr.
BKC.	4318			
Ce.	4465			So.
G. <u>Water</u>	4646			
M.	4671			Pool
M. <u>St. Lou</u>	4753			<u>Damie</u>
K.				
Mz.				
Me.				
V.				
S.				
S.				
A.				
R.				
PE.				
G.				
TD.	5305			

DEC 20 '56
 COMPLETE

Date Comm. MICT OCT 10 '56 10-3-56 872 281/125
103018 OCT 17 '56 104348 OCT 24 '56 104809
 OCT 31 '56 5 1/2 5305 NOV 7 '56 MICT NOV 13 '56
CO 5207 311-4757-63 8 57 130 6 hrs
grass 32° NOV 21 '56 ✓ NOV 28 '56 DEC 5 '56 ✓
 DEC 12 '56 ✓ DEC 19 '56 54 P. 313.35
Boyd 120/150W grass 29.8°