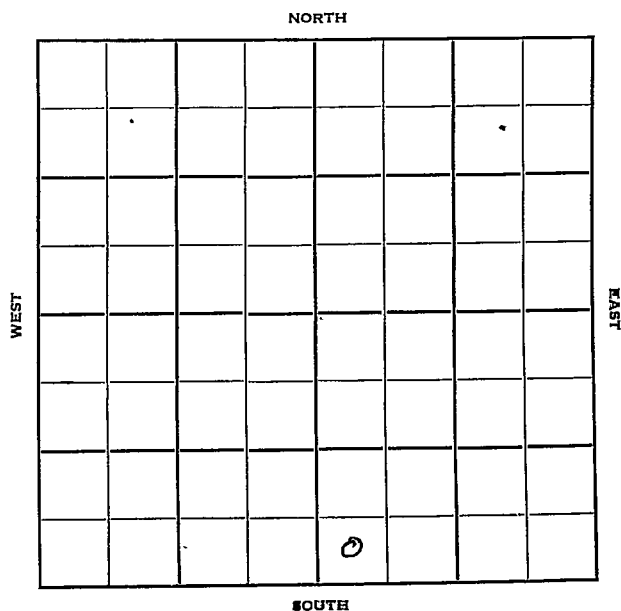


Section 28 Township 22 Range 33WWell No. #10 DammeCompany W. L. Hartman

Finney

KANSAS

Sec. 28 Twp. 22 R. 33W

Well No. #10 Damme Farm


W. L. Hartman Company

Contractor

Ft. from N. Line

330 Ft. from S. Line

Ft. from E. Line

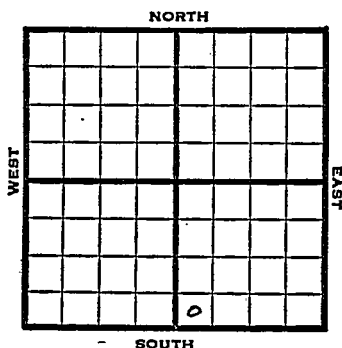330 Ft. from W. Line
SW SW SE

1952

Elev. 2890' REPORT

10/1 8" @ 280

Drlg. 1920

10/8 Drlg. 3366'

10/15 Heeb 3802 Lans 3831

Drlg. 4230'

10/22 Marm 4321' Cherokee 4460'

Drlg. 4638'

10/29 Patterson sd 4650, Miss 4690-4776 RTD
5" @ 4767'

11/5 NR

11/122 P/10 BOPH

11/20 CO 4776'

11/27 NR

12/4 "

12/11 NR

12/17 Oil Well

TD 4776'

8" @ 280

Heeb. 3802, Lans 3831', Marm
4321, Cherokee 4460, Patterson
sd. 4650, Miss 4690

TD 4776

5" @ 4767 P/10 boph CO to 4776
Comp. 244 bopd**COMPLETED**

J. G. McGEHEE

County Finney State Kansas

Sec. 28 (Blk. Twp.) 22 (Sur. Rge.) 33W Map No.

Operator W. L. Hartman

Well No. 10 Farm Darms

Elev.	2890	Location	SW SW SE
-------	------	----------	----------

COMPLETE

330 Ft. From S Line SE

330 Ft. From W Line Quarter

1st. Report

Completion DEC 17 1952

Remarks

Spudding Date _____

Drilg. Data Oil well TD 4776

8"@ 280 Heeb. 3802 Lans. 3831

Marm. 4321 Cherokee 4460 Patterson sd.

4650 Miss. 4690 TD 4776 5" @ 4767

P/ 10 boph CO to 4776

Comp. 244 bopd