


Section 28 Township Finney 22 Range KANSAS 39W
Well No. 7 Damme
Company W. L. Hartman

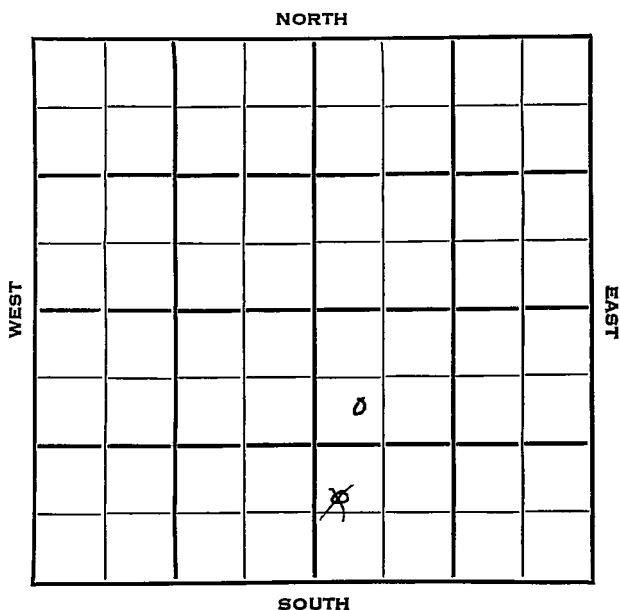

Finney

KANSAS ✓

Sec. 28 Twp. 22 R. 33WWell No. #7 Damme FarmW. L. Hartman

Company

S. Damme Pool

Contractor

990

Ft. from N. Line


990

Ft. from S. Line

Ft. from E. Line

330

Ft. from W. Line

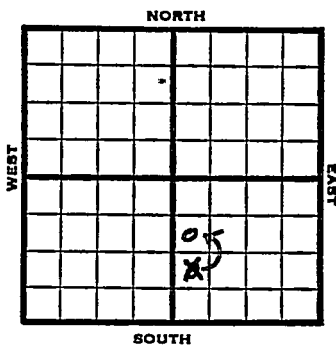~~NW SW SE~~**SW NW SE**

1952

Elev. 2880: REPORT

12/17

10" @ 290

Hol 2486, Her. 2513, Kri 2531,
Win. 2575, Ft. Riley 2621,

Td 2685

7" @ 2685

WOCT

12/25

WOCT

1/1

WOCT

1/8

WOCT

1/22

"

1/29

"

2/5

"

2/12

"

2/19

"

2/26

WOCT

3/12

"

3/19

NR

3/26

NR

4/2

"

4/9

NR

4/16

"

OVER

#7 Damme

1953

4/22

Gas Well

TD 2685

10" @ 290

Hol 2486, Her 2513, Kri 2531, Win
2575, Ft. Riley 2621,

TD 2685

7" @ 2685

Comp. 1,471,000 gas

4/29

Additional information

404/2512-98

51000 A

COMPLETED

J. G. McGEHEE

Kansas

Map No. _____ Sec. 28 Twp. 22 R. 33W

Well No. 7 Damme

W. L. Hartman Company

CORRECTION Contractor

SW NW SE


2878
SECTION PLAT

990 Ft. from N. Line

_____ Ft. from S. Line

_____ Ft. from E. Line

330 Ft. from W. Line

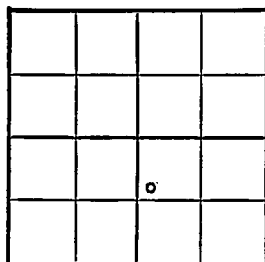

Finney County

Location _____

Rig up _____

Drilling and Remarks:

Reported

NW SW SE

RECORD

Cased _____ in., _____ ft.

Sand _____

Gas _____

Oil _____

Total Depth _____

PRODUCTION

1st 24 hrs. Nat. _____

1st 24 hrs. after shot _____

Gas _____ Cu. Ft.

Dry Hole _____

Abandoned _____

Date

DEC 23 1952 19

J. G. McGEHEE Scout

County Finney State Kansas

Sec. 28 (Blk. Twp.) 22 (Sur. Rge.) 33W Map No.

Operator W. L. Hartman

Well No. 7 Farm Damme

Elev.	2878	Location	SW NW SE
-------	------	----------	----------

COMPLETE

990 Ft. From N Line SE

330 Ft. From W Line Quarter

1st. Report

Completion APR 22 1953

Remarks S. Damme Pool

H & H Drlg. - Contr.

Spudding Date _____

Drlg. Data Gas well TD 2685

10" @ 290 Hol. 2486 Her. 2513

Kri. 2531 Win. 2575 Ft. Riley 2621

TD 2685 7" @ 2685

Comp. 1,471,000 gas

Kausa

Map No. _____ Sec. 28 Twp. 22 R. 33WWell No. 7 Damme_____
W. L. Hartman _____ Company_____
Contractor

SW NW SE

990 Ft. from N. Line

_____ Ft. from S. Line

_____ Ft. from E. Line

330 Ft. from W. Line

SECTION PLAT

		0	

Finney County

Location _____

Rig up _____

Drilling and Remarks:

Additional inform. _____

Comp. 4-22-53404/ 2512-9851000 A

RECORD

Cased _____ in., _____ ft.

Sand _____

Gas _____

Oil _____

Total Depth _____

PRODUCTION

1st 24 hrs. Nat. _____

1st 24 hrs. after shot _____

Gas _____ Cu. Ft.

Dry Hole _____

Abandoned _____

Date

APR 29 1953J. G. McGEHEE Scout