FORM 51 10M 2-49 PETROL

KANSAS

Finney

Section 28 Township 22 Range 34W

Well No. 1 Anderson

Company Warren Pet.

Hugoton

NORTH

WEST

EAST

SOUTH

FORM 252-A
5M 10-48 PETROL

KANSAS

Sec. 28 Twp. 22 R. 34W

Well No. #1 Anderson Farm

Warren Pet. Company

Hugoton Pool(Burris, Cont.)

660' Ft. from N. Line

Ft. from S. Line

660' Ft. from E. Line

Ft. from W. Line

C NE SW

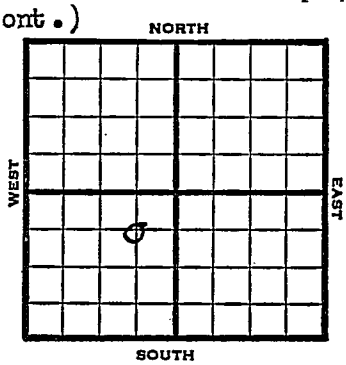

1949	Elev 2954' REPORT
7/20	Location
7/27	"
8/3	RUR
8/10	10" @ 296' TD 2470' 7" @ 2468'
8/17	TD 2620'
8/24	140 qts
8/31	"
9/7	"
9/14	TD 2620' 7"@ 2468' 178' of 5" Perf Liner @ 2620' 21000 acid 9,040,000 Gas 400# R Pr. Comp

COMPLETED

Form 26-200 Bks. 6-49 Petrol

Hugoton Pool

Kansas

Map No. _____ Sec. 28 Twp. 22 R. 34W

Well No. 1 Anderson

Warren Pet. Company

Burris Contractor

C NE SW

FIRST REPORT

SECTION PLAT

660 Ft. from N. Line

Ft. from S. Line

660 Ft. from E. Line

Ft. from W. Line

Finney County

Location x

Rig up

Drilling and Remarks:

RECORD

Cased _____ in., _____ ft.

Sand

Gas

Oil

Total Depth

PRODUCTION

1st 24 hrs. Nat.

1st 24 hrs. after shot

Gas _____ Cu. Ft.

Dry Hole

Abandoned

Date

JUL 20 1949 19

S. J. LEWIS Scout

Form 26 200 Bks. 6-49 Petrol

Kansas

Hugoton Pool

Map No. ✓ Sec. 28 Twp. 22 R. 34W

Well No. 1 Anderson

Warren Pet. Company

COMPLETE

Contractor

C NE SW

E1,2954

SECTION PLAT

660 Ft. from N. Line

Ft. from S. Line

660 Ft. from E. Line

Ft. from W. Line

Finney County

Location

Rig up

Drilling and Remarks:

7" @2468

178 of 5" Reg liner

@ 2620

21000 acid

9,040,000 Gas

400 # RP

RECORD

Cased in., ft.

Sand

Gas

Oil

Total Depth 2620

PRODUCTION

1st 24 hrs. Nat.

1st 24 hrs. after shot

Gas Cu. Ft.

Dry Hole

Abandoned

Date

SEP 14 1949 19

S. J. LEWIS Scout