
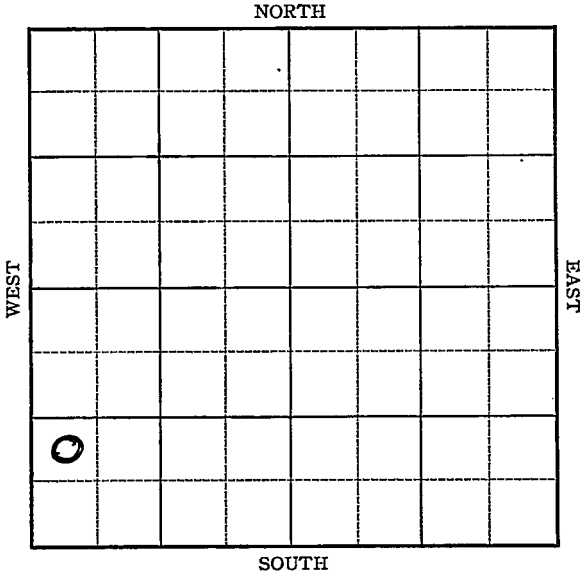


Staffard

Section 29 Township 22 Range 11-WWell No. 3 - P. SpangenburgCompany Stanolind O&G

Sec. 29 Twp. 22 R. 11-WWell No. #3 P. Spangenburg Farm
Stanolind O & G Company Ft. from N. Line990 Ft. from S. Line Ft. from E. Line330 Ft. from W. Line

Elev. 1820

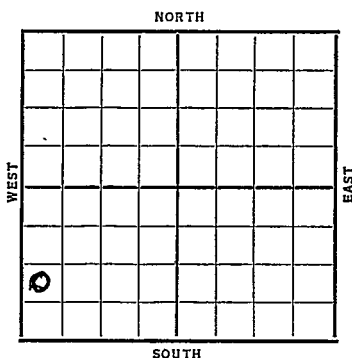

Date	REPORT
1937	
9/1	Cellar
9/10	T.D. 248'. Rng. pipe.
9/17	13" @ 247'. Anhy 523'.
	Drlg. 1910'.
9/24	Drlg. 3474'.
10/2	Sil. 3544'. T.D. 3553'.
	6" @ 3542'. No shows reported.
10/8	" " " " "
10/15	T.D. 3570'. 2000 acid.
	Swab 87 BOPH.
10/20	13" @ 247'.
	6" @ 3542'.
	Sil. 3544'.
	T.D. 3570'.
	2000 acid.
	Potential 2011 bbls.
	COMPLETED

KANSAS

Map No. _____ Sec. 29 Twp. 22 R. 11WWell No. 3-P. Spangenburg
Stanford Oil Co. Company

Contractor _____

FIRST REPORT

SECTION PLAT

0			

_____ Ft. from N. Line

990 Ft. from S. Line

_____ Ft. from E. Line

330 Ft. from W. Line

Location _____

Rig up _____

Drilling and Remarks:

cellar

RECORD

Cased _____ in., _____ ft.

Sand _____

Gas _____

Oil _____

Total Depth _____

PRODUCTION

1st 24 hrs. Nat. _____

1st 24 hrs. after shot _____

Gas _____ Cu. Ft.

Dry Hole _____

Abandoned _____

Date

SEP 1 1937H. D. Hatfield Scout

KANSAS

Stafford

Map No. _____ Sec. 29 Twp. 22 R. 11WWell No. 3 P SpangenburgStanolind Company

Contractor

COMPLETED

NW SW SW

_____ Ft. from N. Line

990 Ft. from S. Line

_____ Ft. from E. Line

330 Ft. from W. Line

SECTION PLAT

0			

Location _____

Rig up _____

Drilling and Remarks:

2000 AcidPOT 201113" - 247
RECORDCased 6 in., 3542 ft.Sand 511 3544

Gas _____

Oil _____

Total Depth 3570

PRODUCTION

1st 24 hrs. Nat. _____

1st 24 hrs. after shot _____

Gas _____ Cu. Ft.

Dry Hole _____

Abandoned _____

Date

OCT 20 1937 19H. D. Hatfield Scout