

KANSAS

Form 51-5M-7-39-Palace


Stafford

Section 29 Township 22 Range 11-W

Well No. #6 Spangenberg

Company Stanolind

NORTH Richardson Pool

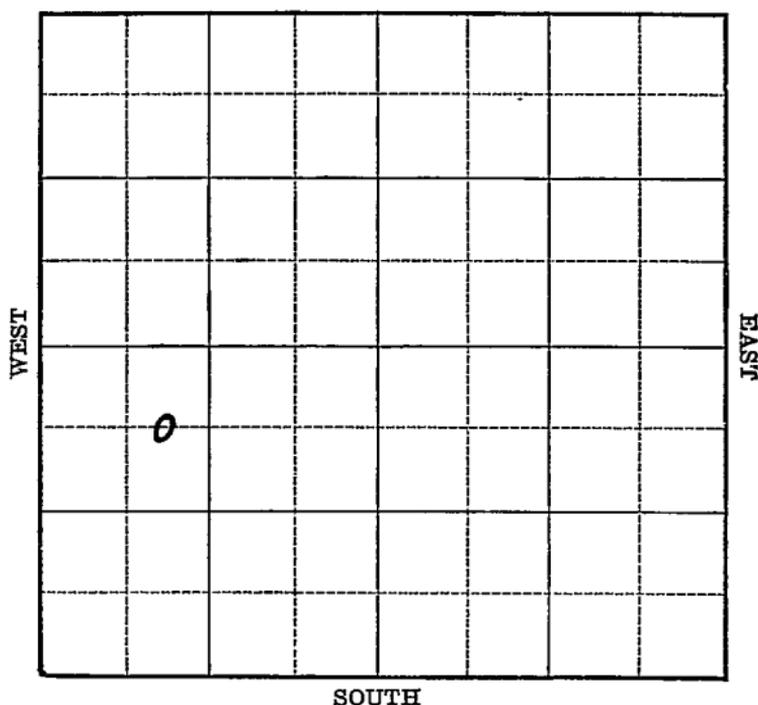

Map No. 46 Sec. 29 Twp. 22 R. 11W

Well No. 6 Spangenberg

Stanolind

Company

Contractor

FIRST REPORT

SECTION PLAT

C E L NW SW

660 Ft. from N. Line

_____ Ft. from S. Line

_____ Ft. from E. Line

990 Ft. from W. Line

RICHARDSON POOL

Location _____

Rig up _____

Drilling and Remarks:

Derrick

RECORD

Cased _____ in., _____ ft.

Sand _____

Gas _____

Oil _____

Total Depth _____

PRODUCTION

1st 24 hrs. Nat. _____

1st 24 hrs. after shot _____

Gas _____ Cu. Ft.

Dry Hole _____

Abandoned _____

Date

APR 17 1940 19

S. J. LEWIS

Scout

Map No. 46 Sec. 29 Twp. 22 R. 11W

Well No. 6 Spangenberg

Stanolind Company

Contractor

COMPLETE

C E L NW SW

660 Ft. from N. Line

_____ Ft. from S. Line

_____ Ft. from E. Line

990 Ft. from W. Line

RICHARDSON POOL

SECTION PLAT

Location _____

Rig up _____

Drilling and Remarks:

Cor & 3556
7" @ 3556
1000 acid
Depth graphed &
9970
Maximum 3000

RECORD

Cased _____ in., _____ ft.

Sand _____

Gas _____

Oil _____

Total Depth 3567

PRODUCTION

1st 24 hrs. Nat. _____

1st 24 hrs. after shot _____

Gas _____ Cu. Ft.

Dry Hole _____

Abandoned _____

Date

MAY 15 1940 19

S. J. LEWIS Scout